




OFFICE - 1,643 SF
WAREHOUSE - 6,637 SF

Key Plan

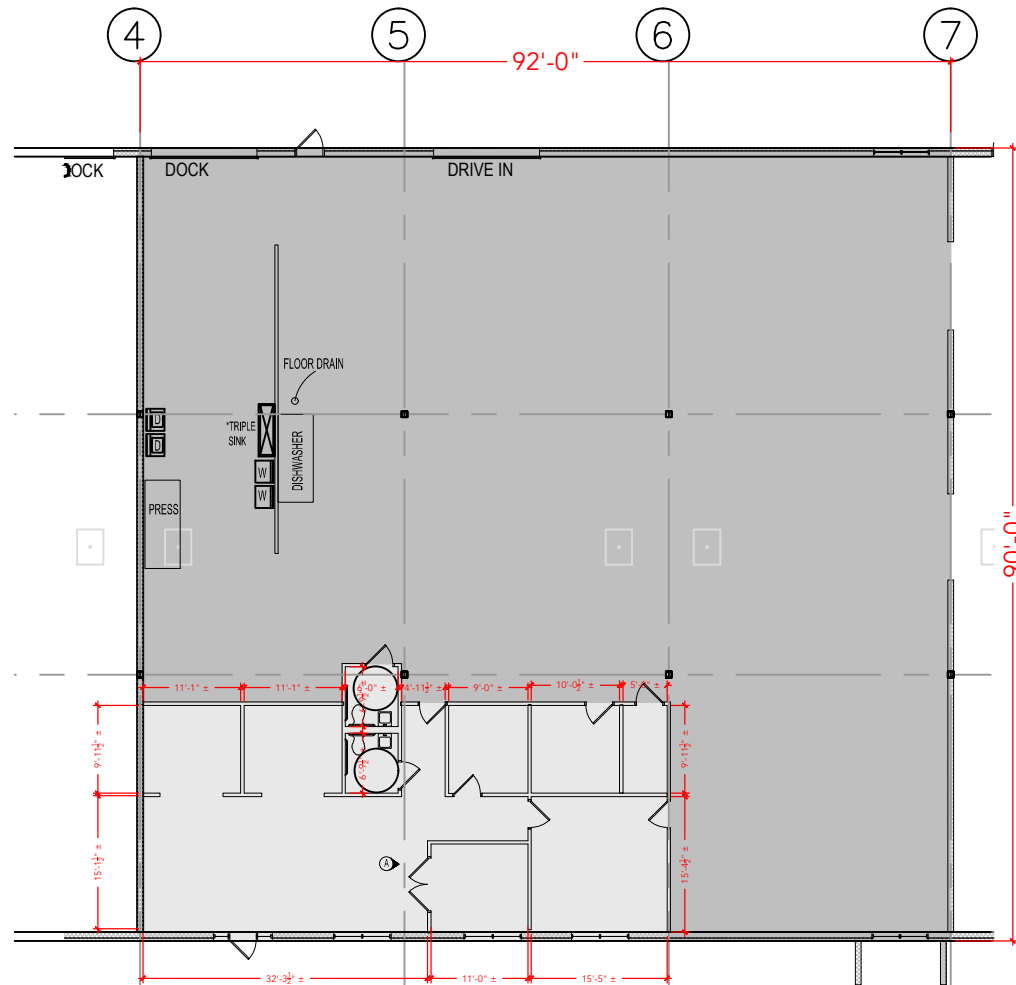

Floor Plan

DRAWING #: 035-104-106 ASBUILT DATE: NEEDS TO BE