


TOTAL SF AVAILABLE - 10,629 SF


OFFICE - 1,643 SF

WAREHOUSE SF - 8,986 SF

[Click to access 3D model](#)

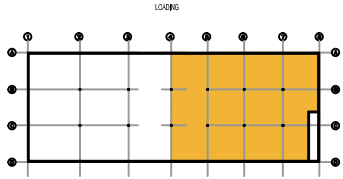

Key Plan

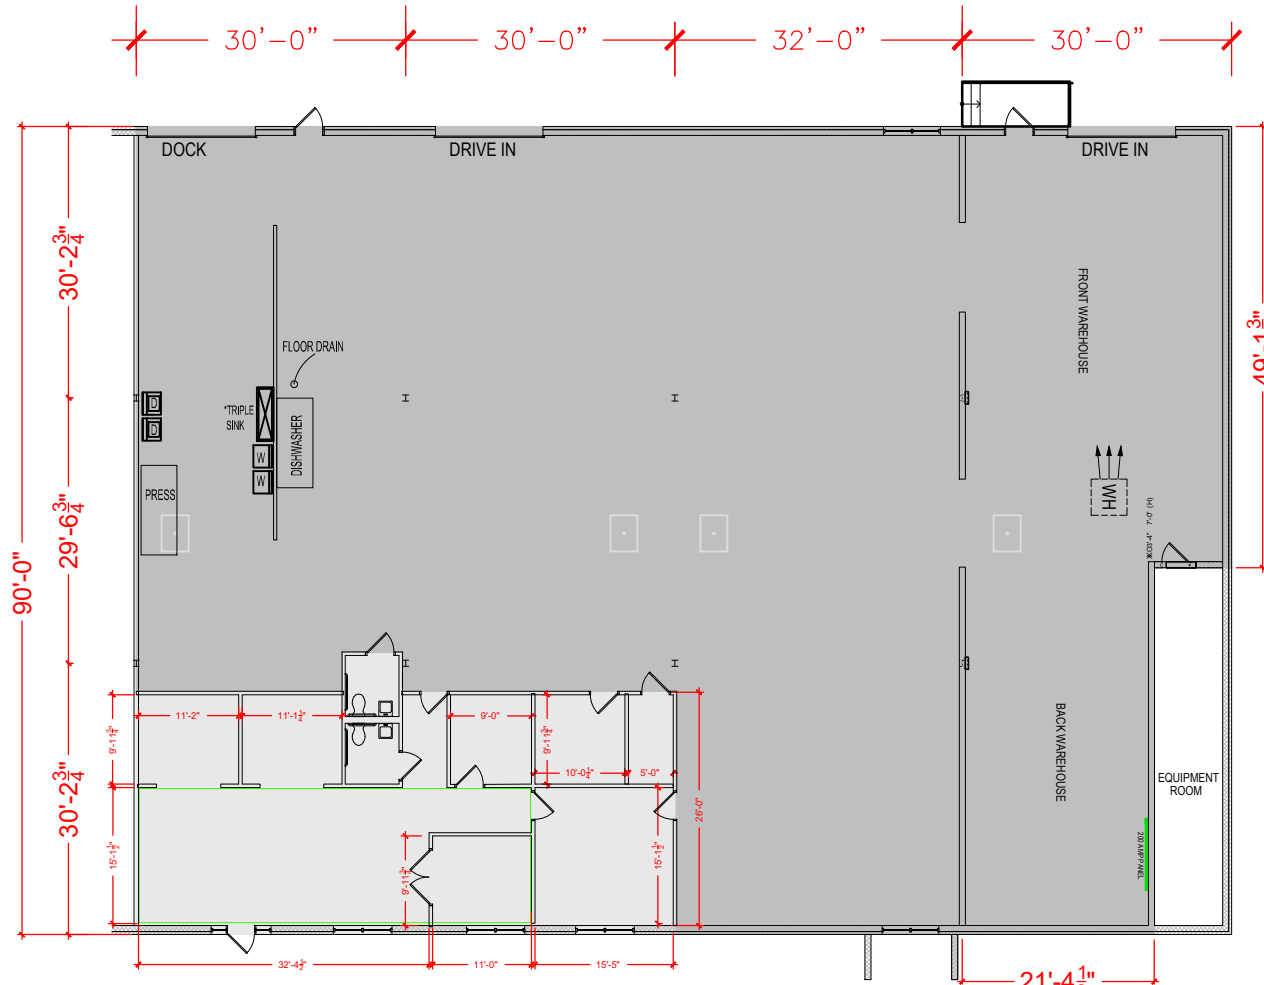

Floor Plan