


TOTAL SF AVAILABLE -23,424 RSF

OFFICE - 5,761 RSF


WAREHOUSE - 17,663 RSF

* INCLUDES % OF METER ROOM

[Click to access CADD file](#)

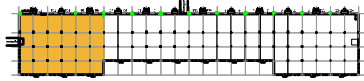

Key Plan

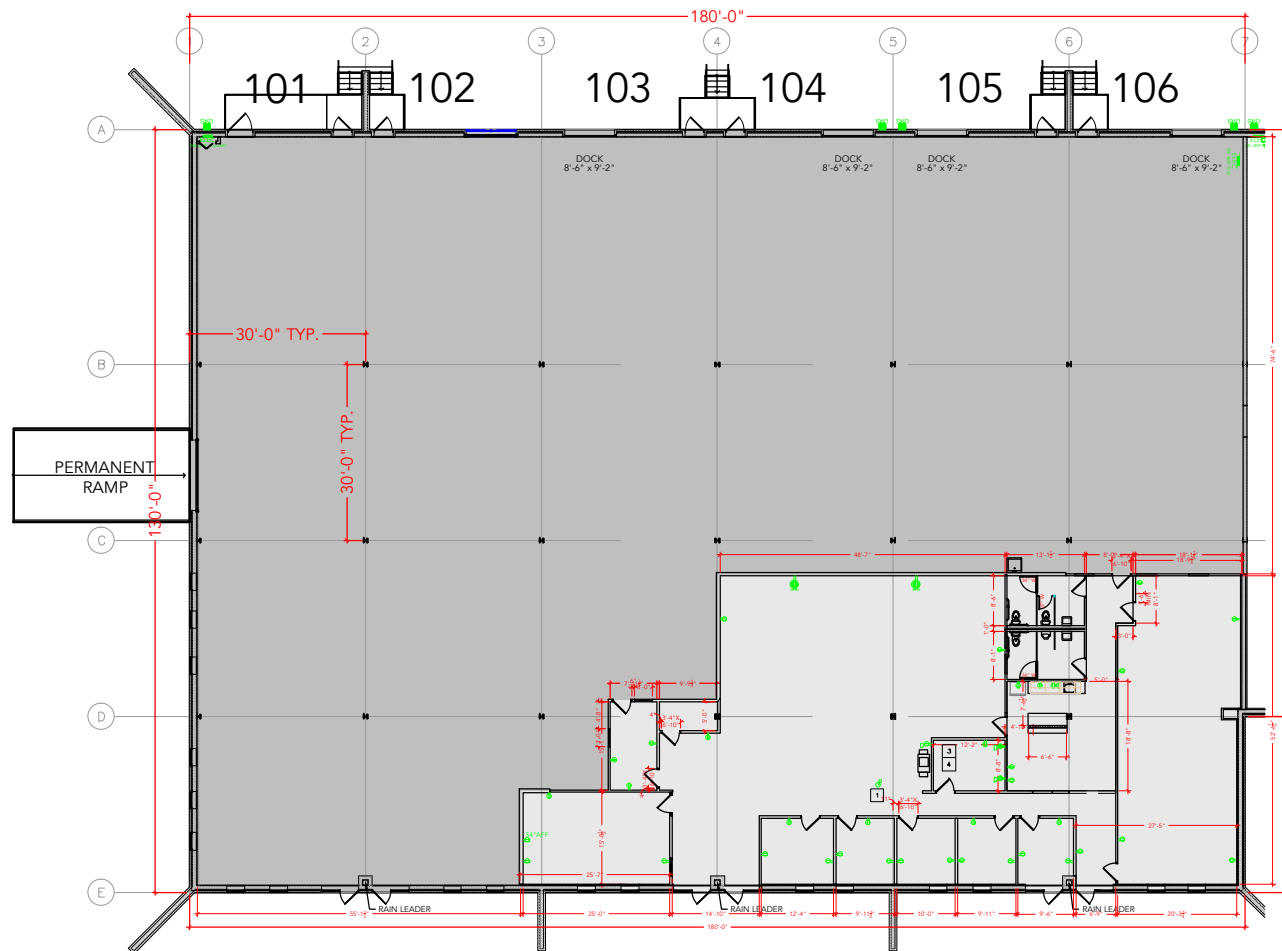

Floor Plan