


**TOTAL SF AVAILABLE -19,500 SF**


OFFICE - 19,500 SF

WAREHOUSE SF - 0,000 SF

[Click to access 3D model](#)

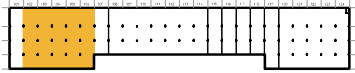

Key Plan

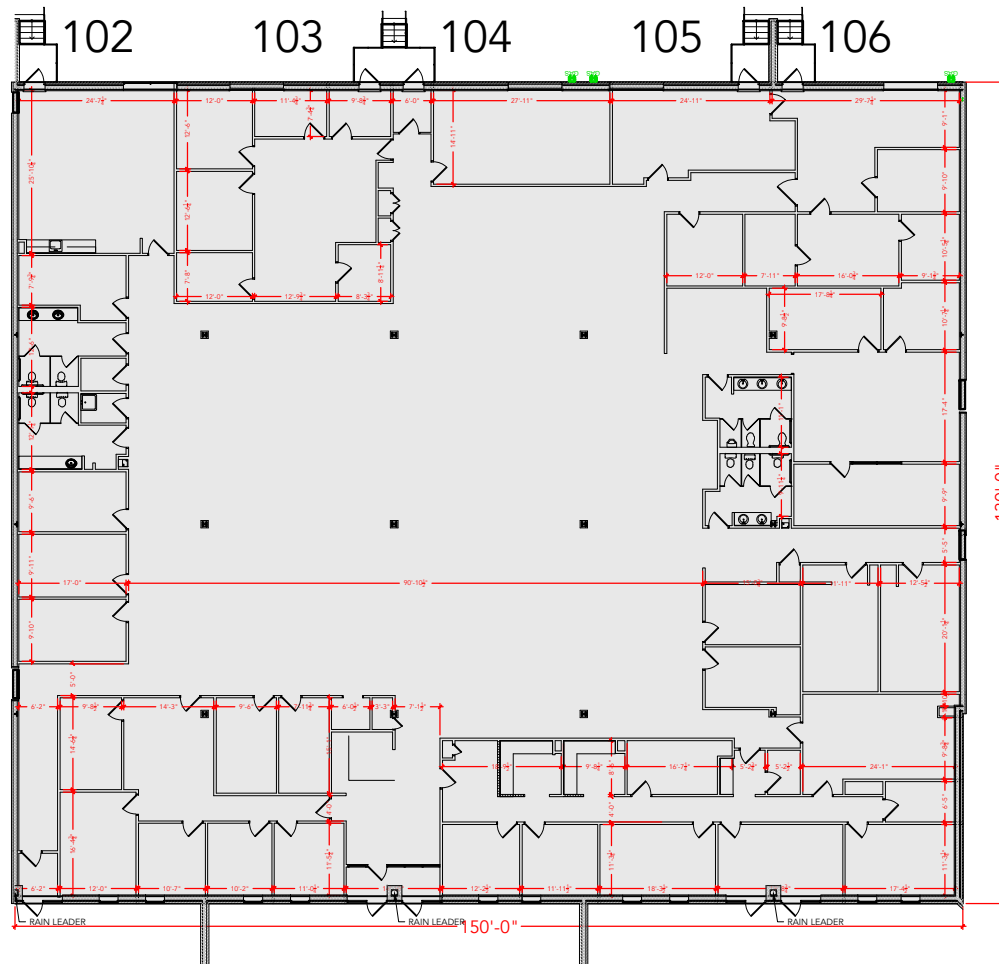

Floor Plan