


TOTAL SF AVAILABLE -3,003 RSF

OFFICE - 1,116 RSF


WAREHOUSE - 1,887 RSF

* INCLUDES % OF METER ROOM

[Click to access CADD file](#)

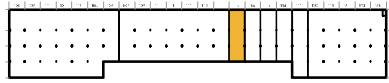

Key Plan

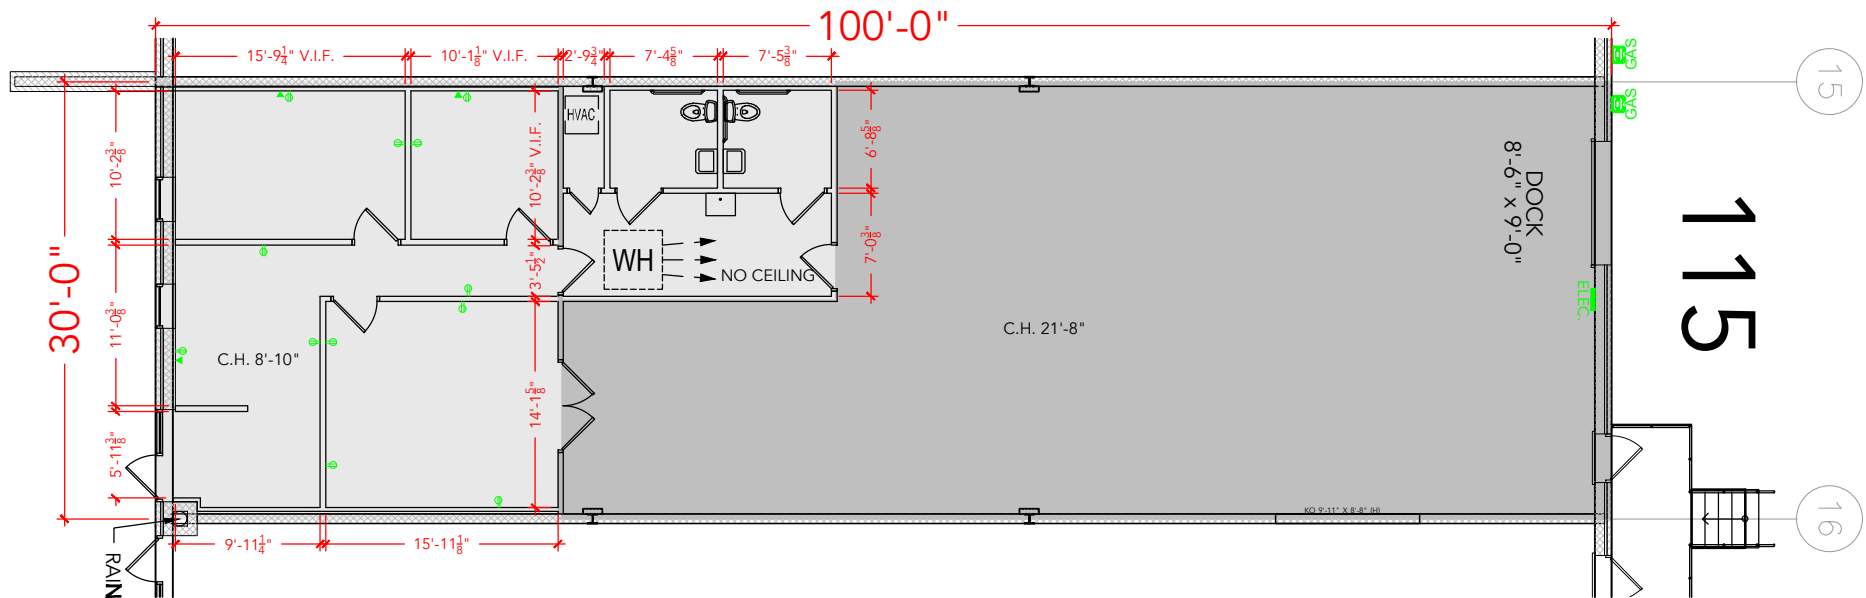

Floor Plan