


TOTAL SF AVAILABLE - 14,853 SF


OFFICE - 14,853 SF

WAREHOUSE - 0,000 SF

[Click to access 3D model](#)

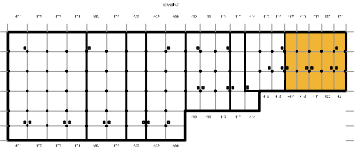

Key Plan

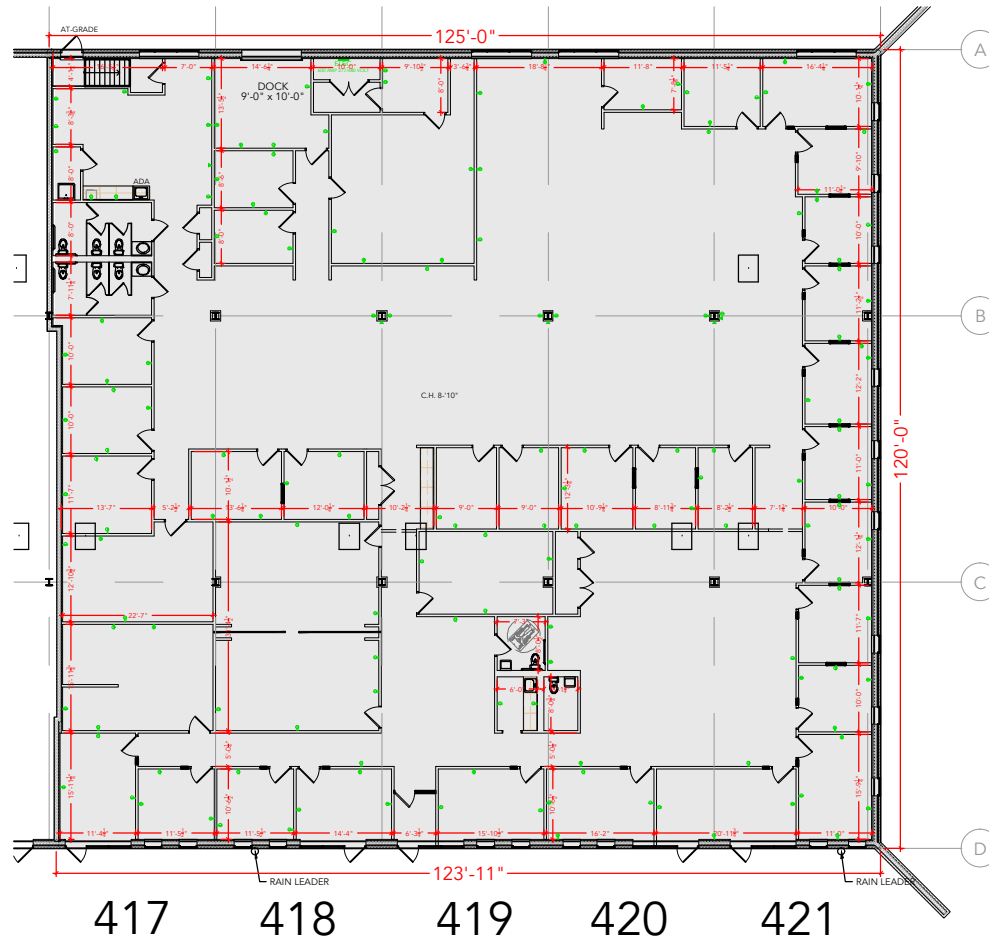

Floor Plan