



TOTAL SF AVAILABLE - 1,500 SF

OFFICE - 1,500 SF
WAREHOUSE SF - 0,000 SF

[Click to access 3D model](#)

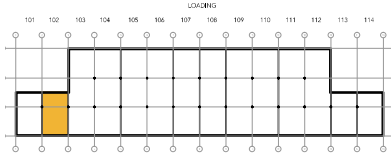

Key Plan

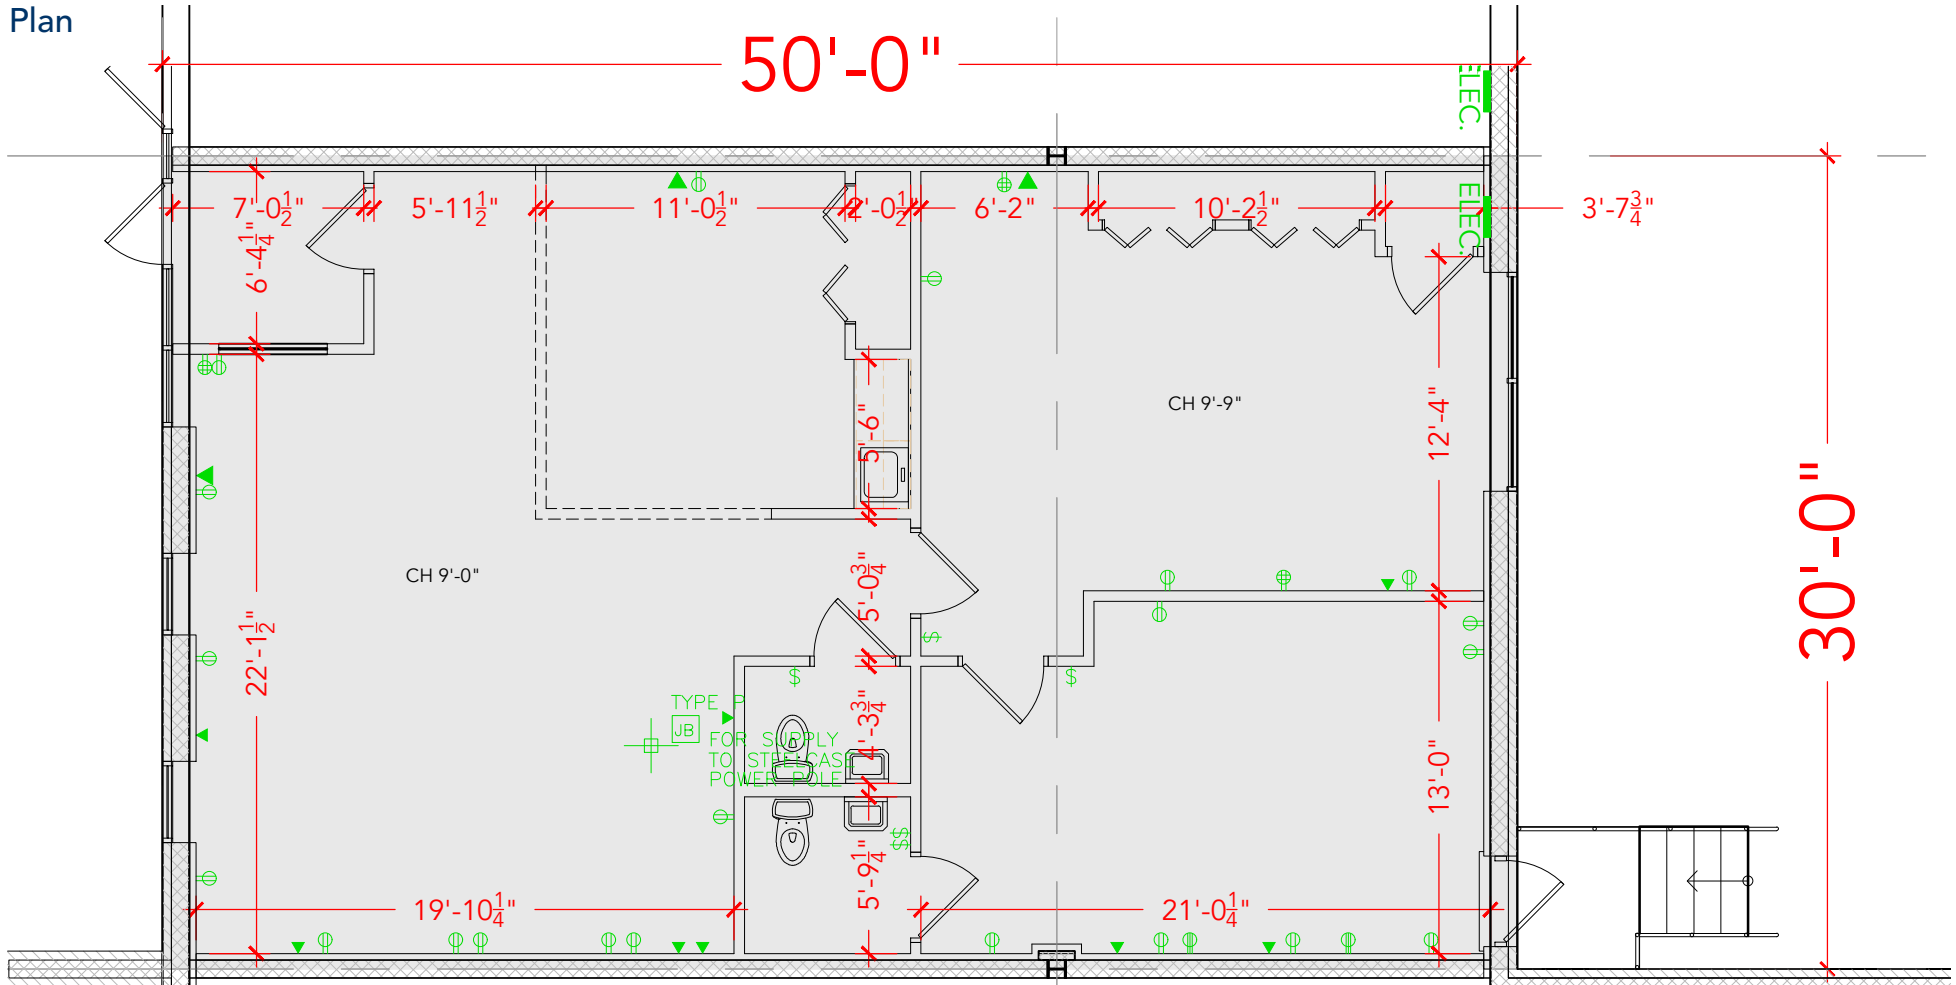

Floor Plan