


TOTAL SF AVAILABLE - 1500 SF


OFFICE - 685 SF

WAREHOUSE - 818 SF

[Click to access CADD file](#)

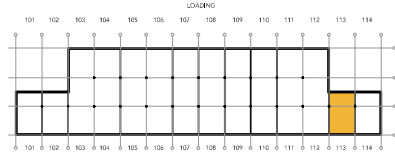

Key Plan

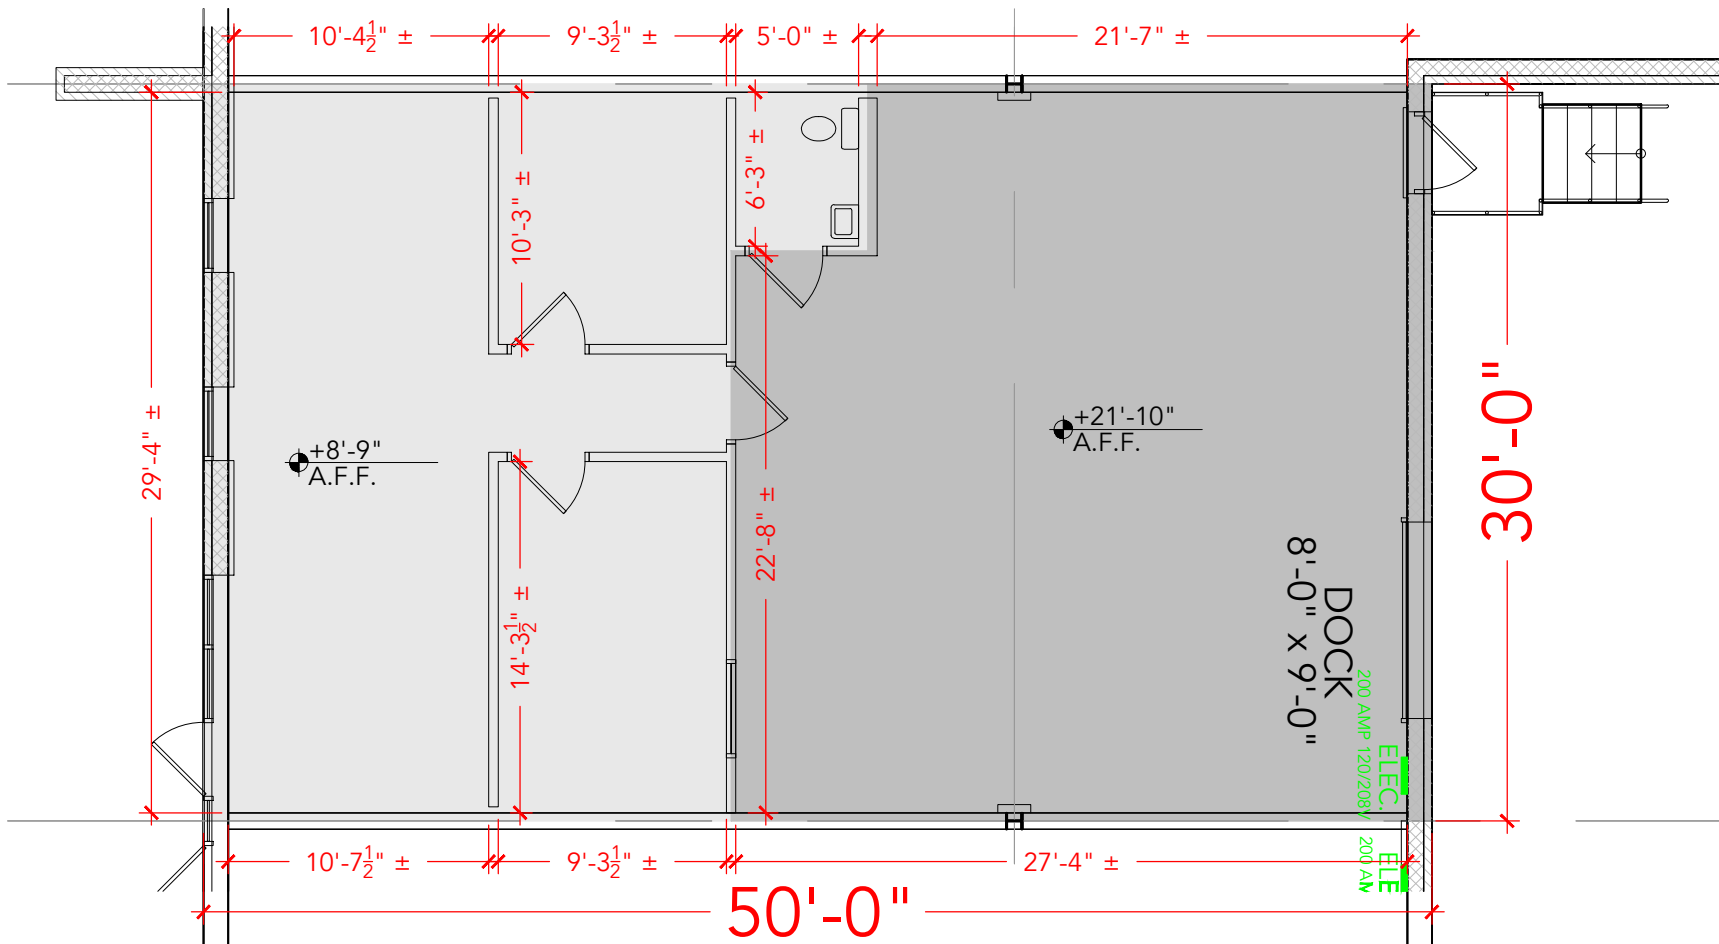

Floor Plan