


TOTAL SF AVAILABLE - 1,500 SF

OFFICE - 1,500 SF


WAREHOUSE - 0,000 SF

[Click to access 3D model](#)

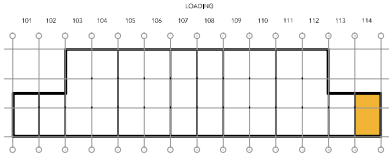

Key Plan

14

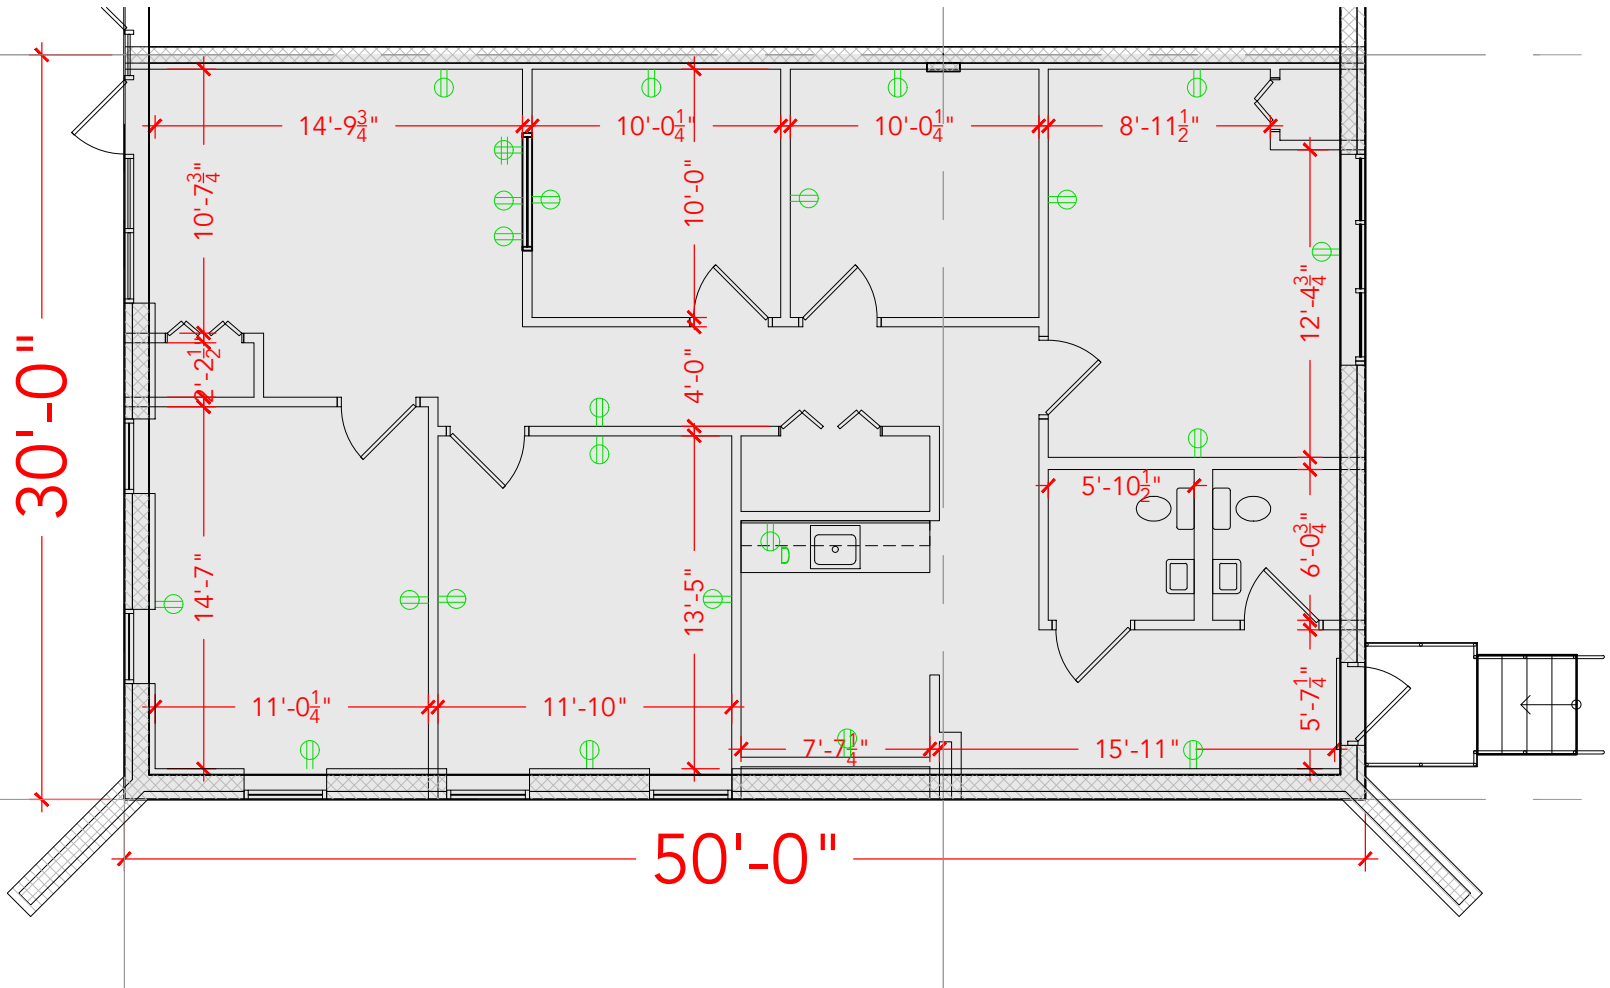

Floor Plan