


**TOTAL SF AVAILABLE - 3,000 SF**


OFFICE - 1,410 SF

WAREHOUSE SF - 1,590 SF

[Click to access 3D model](#)

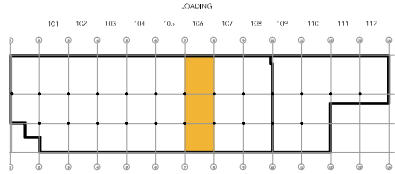

Key Plan

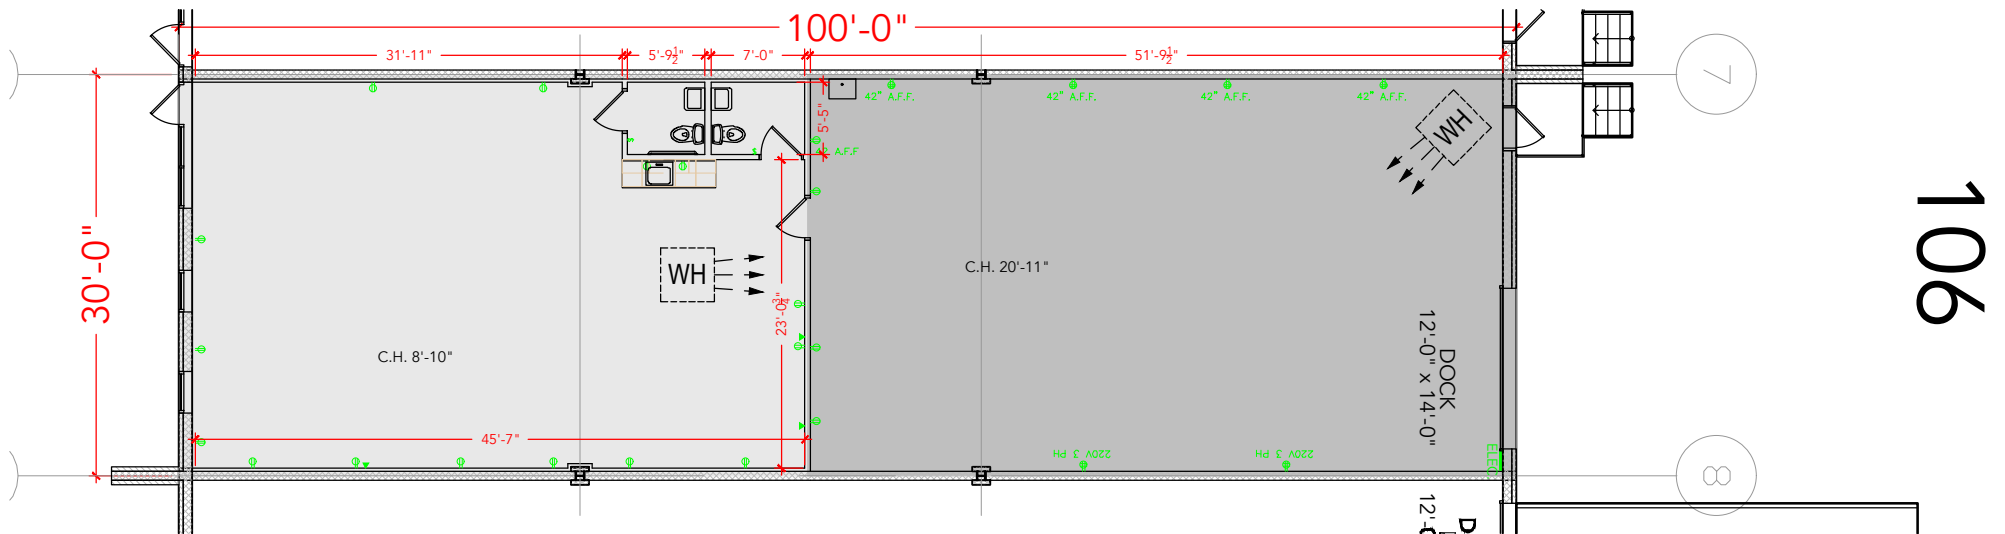

106

Floor Plan