


TOTAL SF AVAILABLE - 6,000 SF


OFFICE - 1,539 SF

WAREHOUSE SF - 4,462 SF

[Click to access 3D model](#)

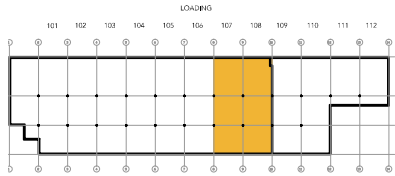

Key Plan

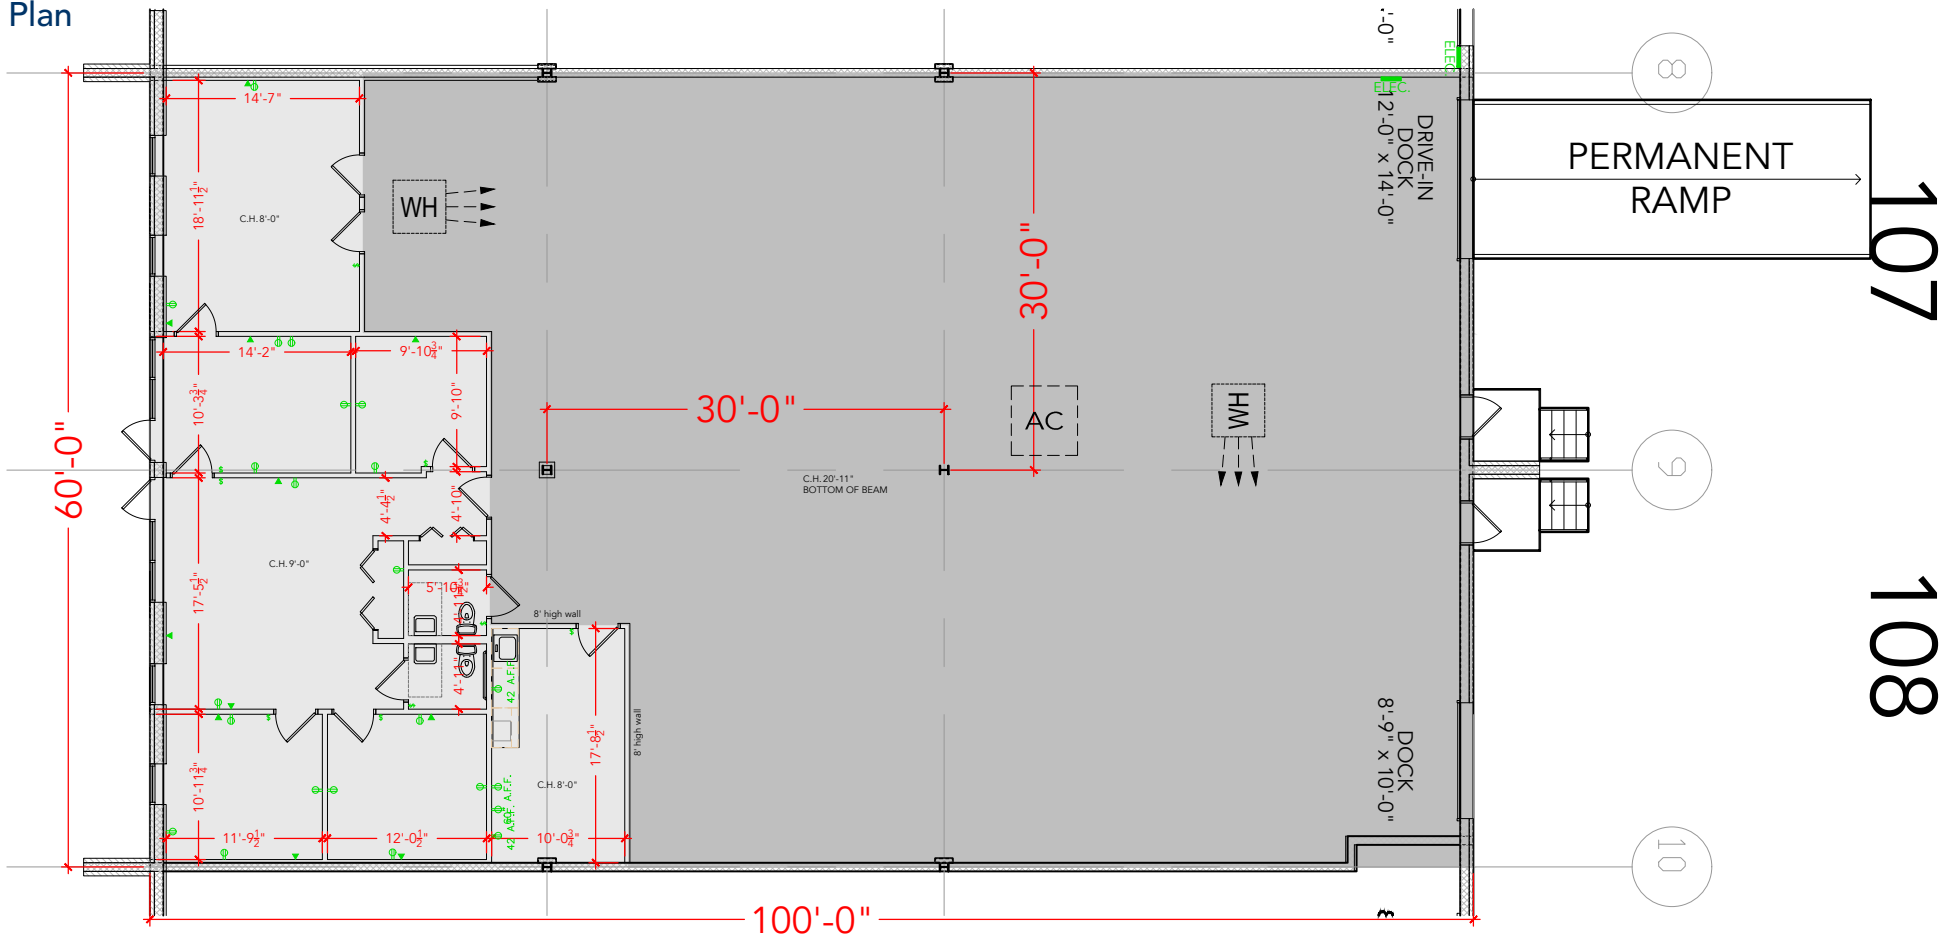

Floor Plan