


**TOTAL SF AVAILABLE - 9,000 SF**

OFFICE - 0,000 SF

WAREHOUSE - 9,000 SF

[Click to access CADD file](#)

Key Plan

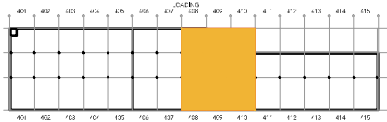

Floor Plan

