


**TOTAL SF AVAILABLE - 6,300 SF**


OFFICE - 4,786 SF

WAREHOUSE SF - 1,514 SF

\* 2,100 SF MEZZ NOT INCLUDED IN TOTAL  
[Click to access 3D model](#)

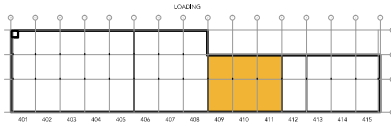


Key Plan

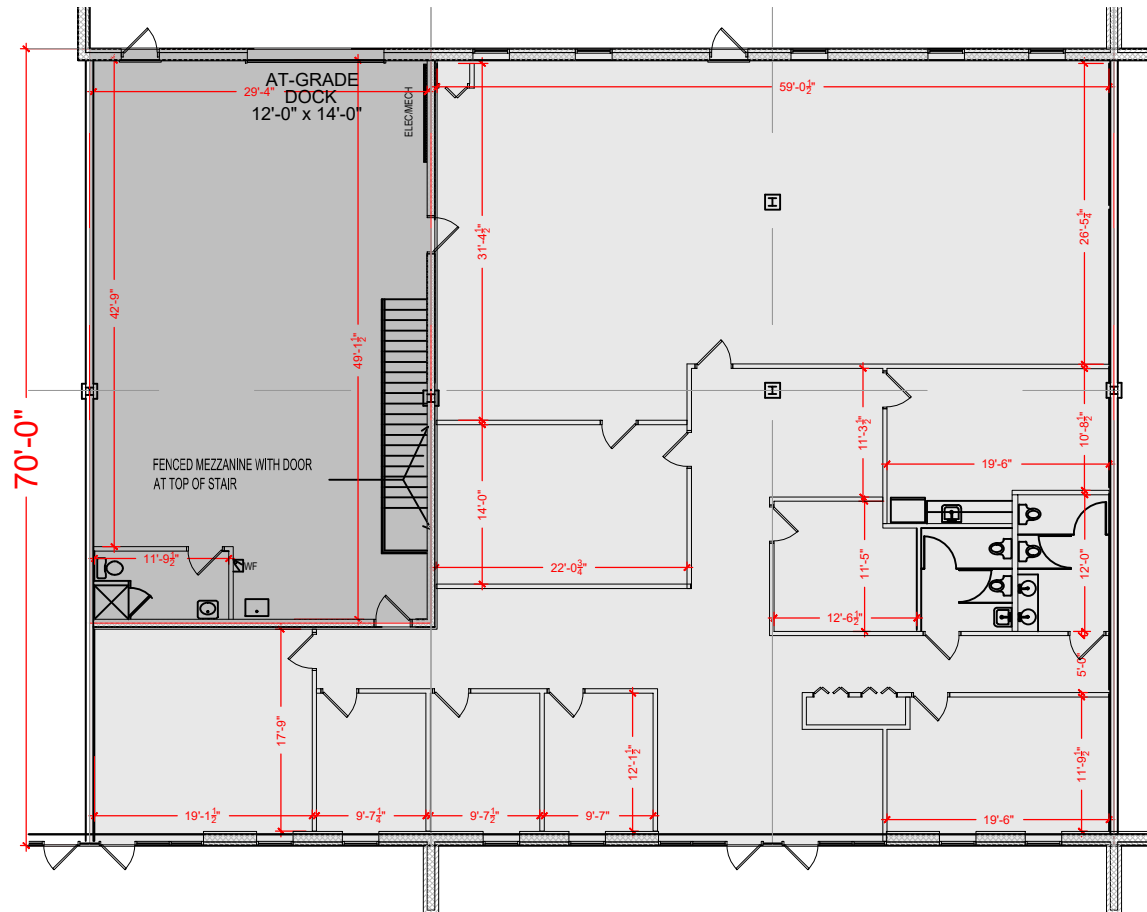

409

410

411

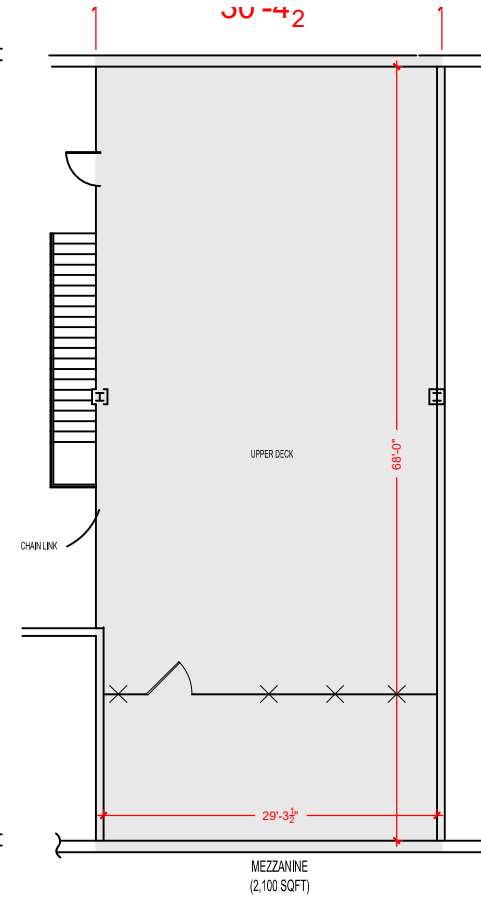

Floor Plan