


**TOTAL SF AVAILABLE - 6,300 SF**

OFFICE - 810 SF

WAREHOUSE SF - 5,490 SF

[Click to access 3D model](#)

## Key Plan

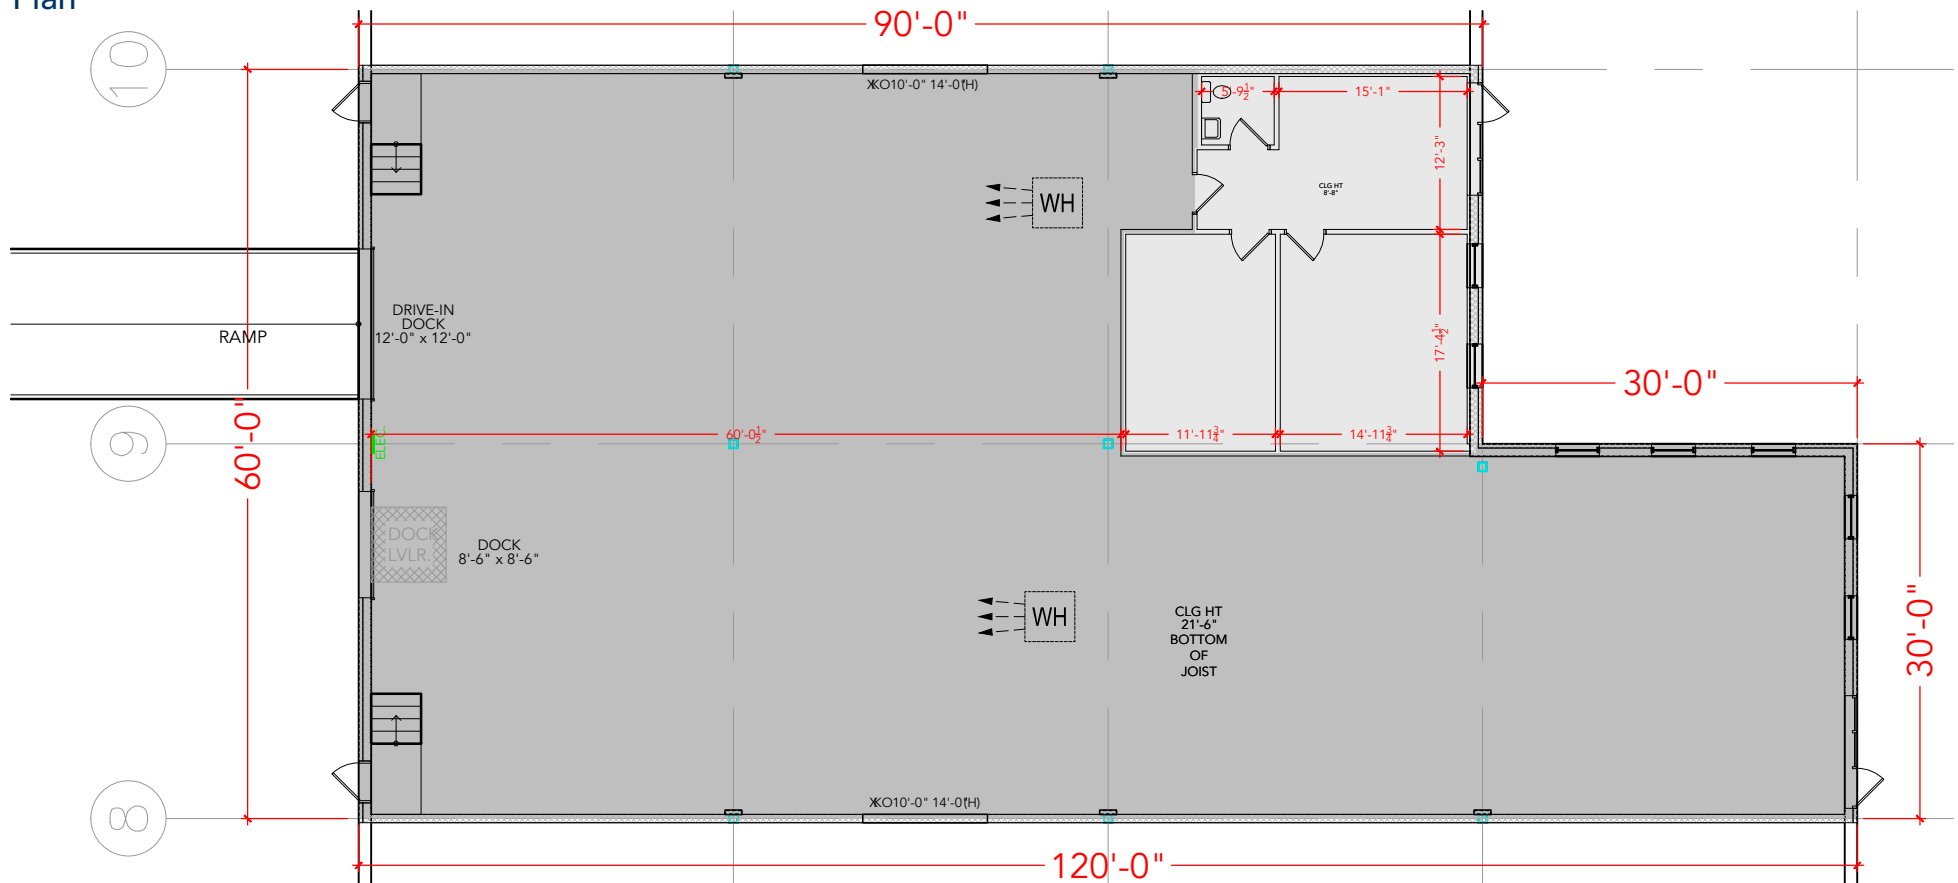

## Floor Plan