


TOTAL SF AVAILABLE - 7,200 SF


OFFICE - 1,164 SF

WAREHOUSE SF - 6,036 SF

[Click to access 3D model](#)

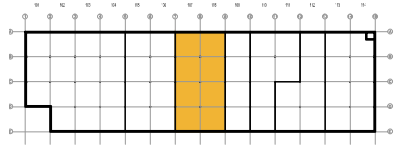

Key Plan

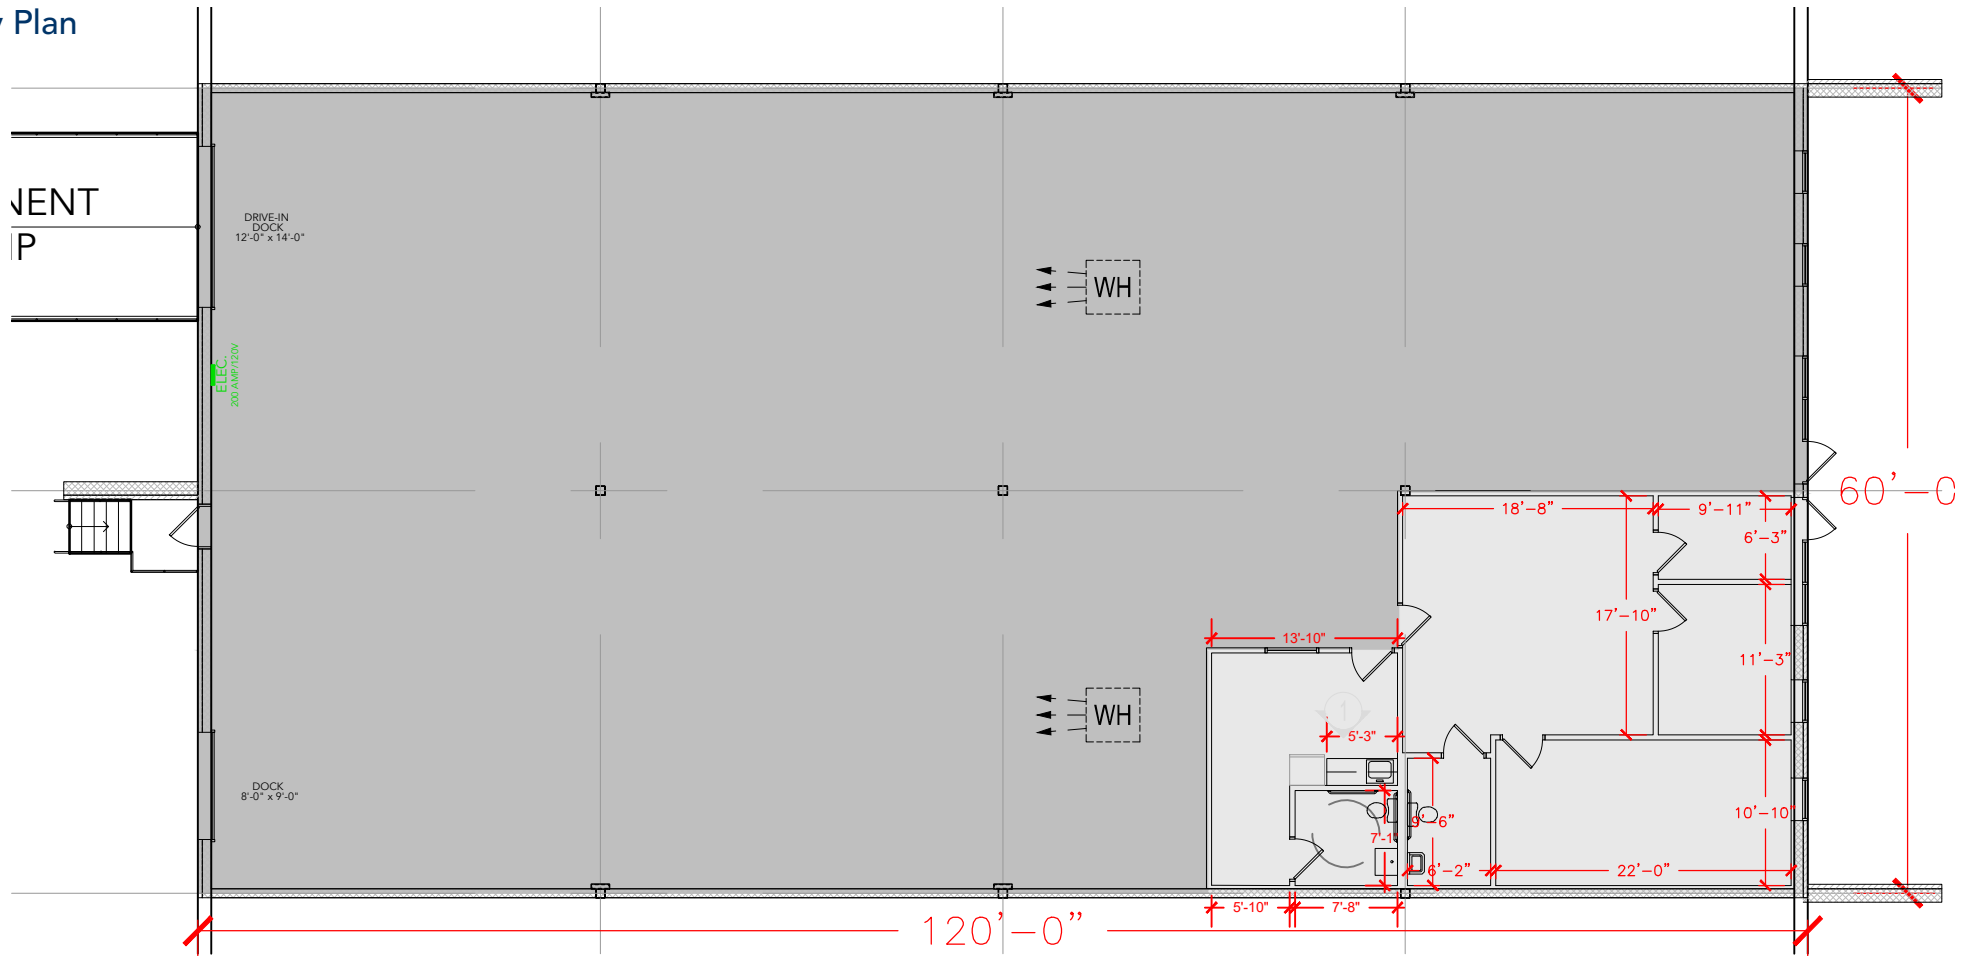

Floor Plan