


**TOTAL SF AVAILABLE -5,410 RSF**

OFFICE - 586 RSF


WAREHOUSE - 4,824 RSF

\* INCLUDES % OF METER ROOM

[Click to access CADD file](#)

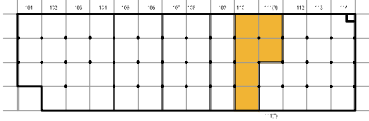

Key Plan

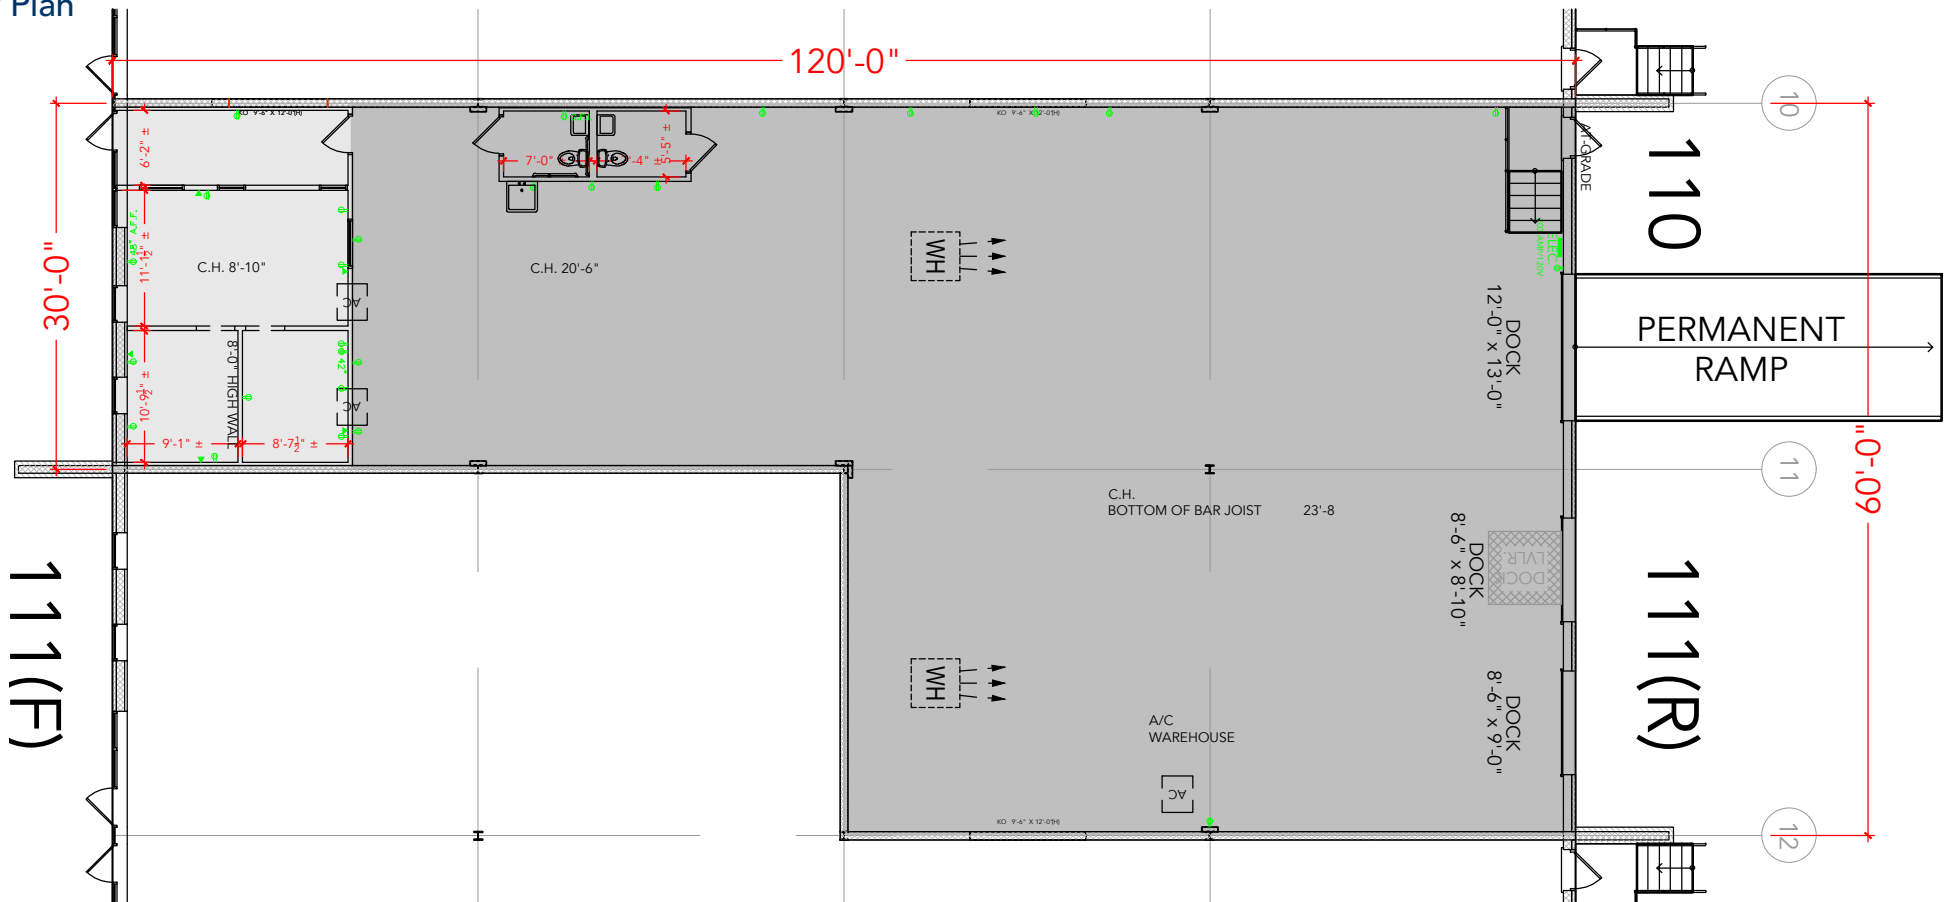

Floor Plan