


TOTAL SF AVAILABLE - 11,200 SF


OFFICE - 1,848 SF

WAREHOUSE SF - 9,352 SF

[Click to access 3D model](#)

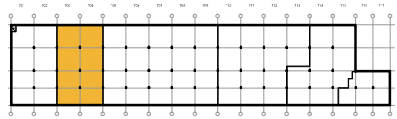

Key Plan

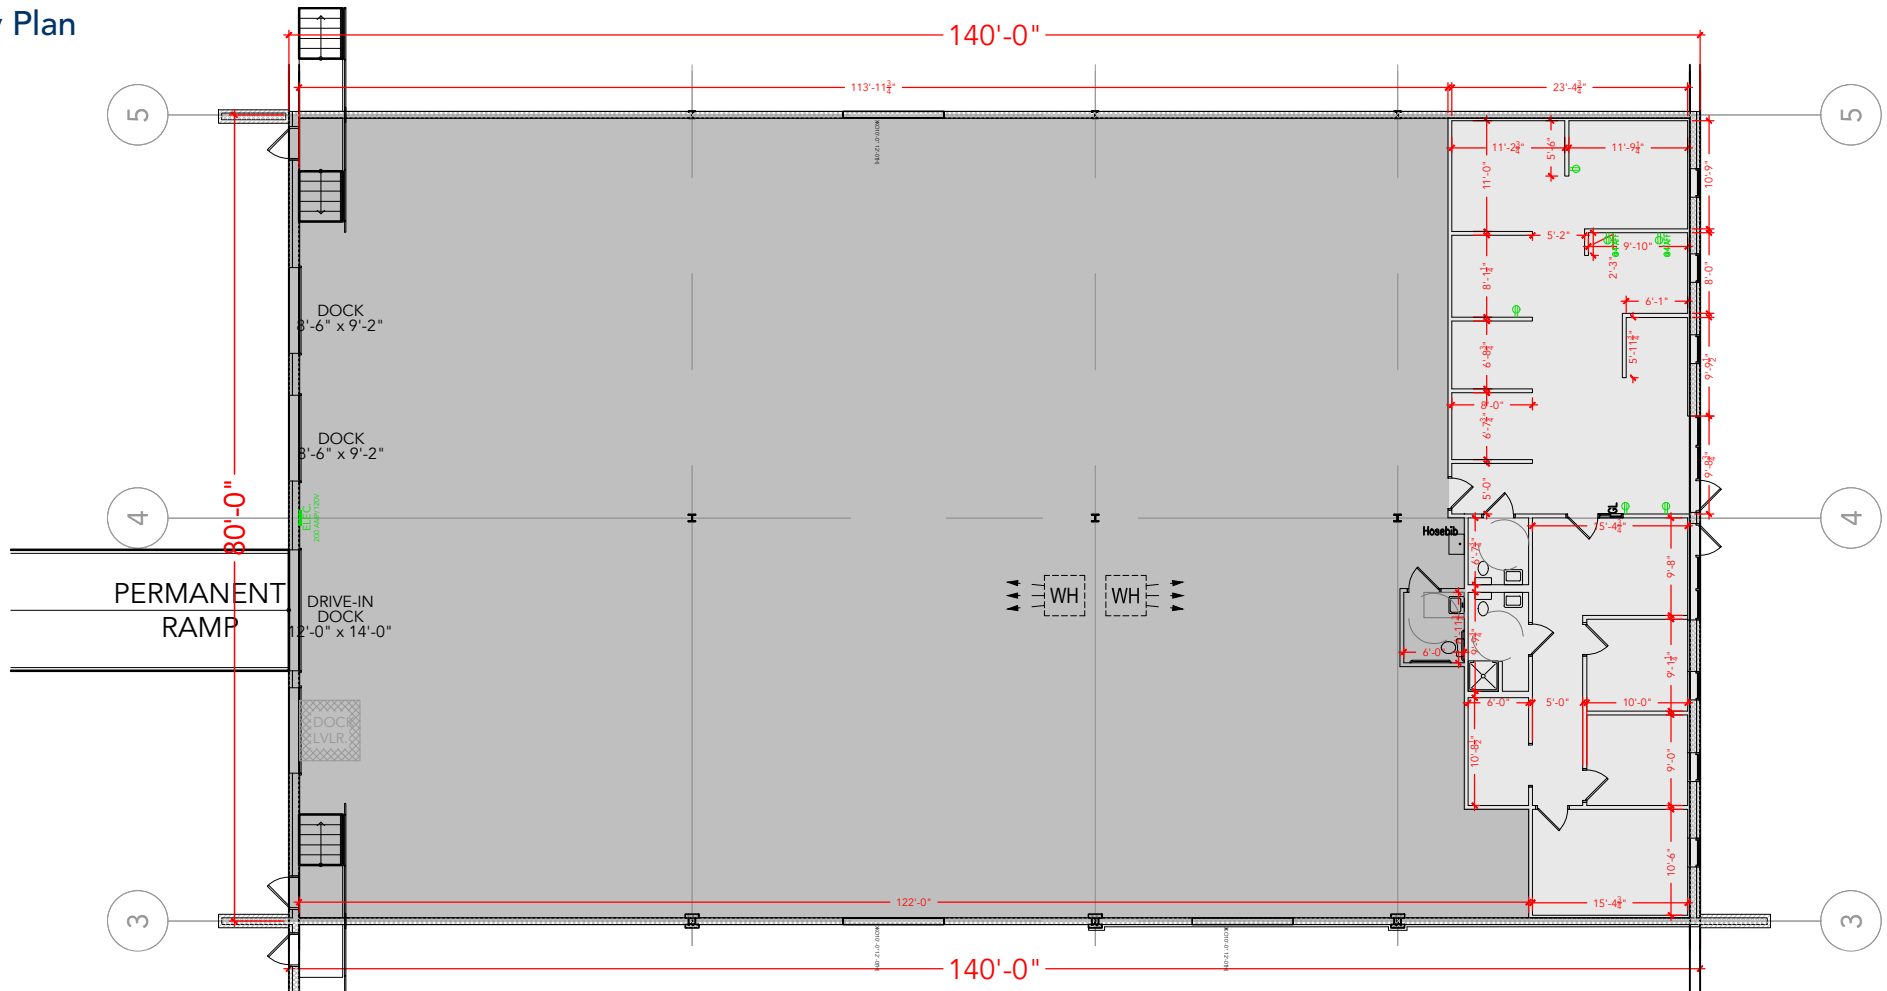

Floor Plan