


TOTAL SF AVAILABLE - 5,629 SF


OFFICE - 1,673 SF

WAREHOUSE - 3,956 SF

[Click to access CADD file](#)

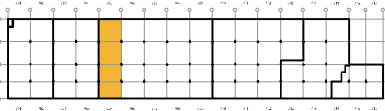

Key Plan

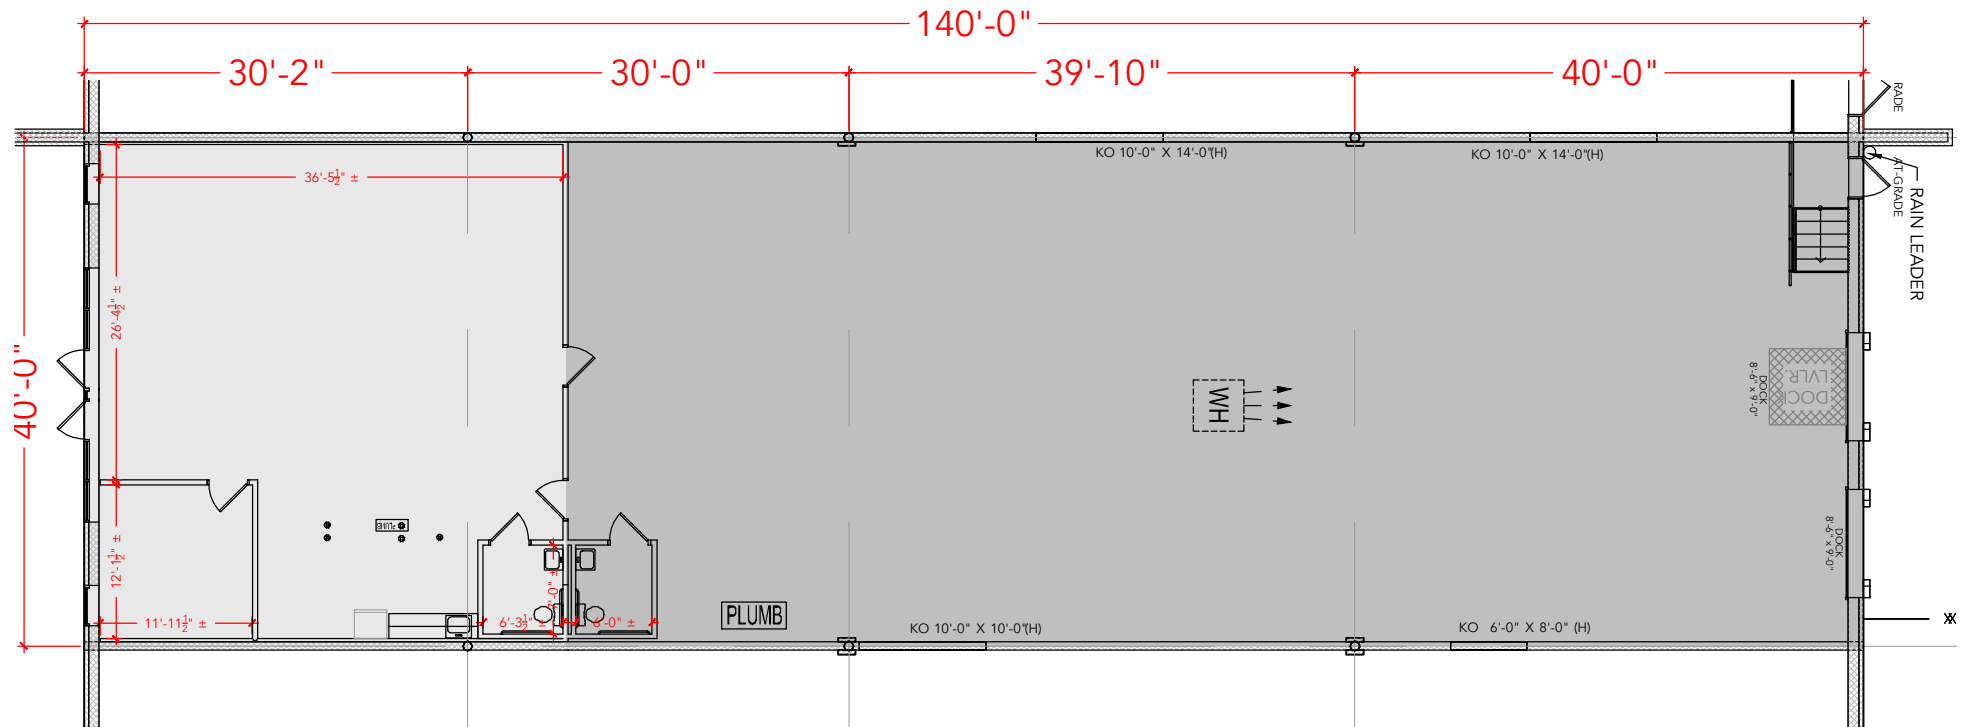

Floor Plan