


Beltway Business Community


3620 Commerce Drive
Suites 715-717
Baltimore, MD 21227

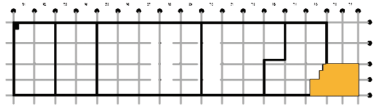

Building Key Plan

Total SF Office Available - 8,830 RSF

First Floor - 4,830 SF
Mezzanine Level - 4,000 SF

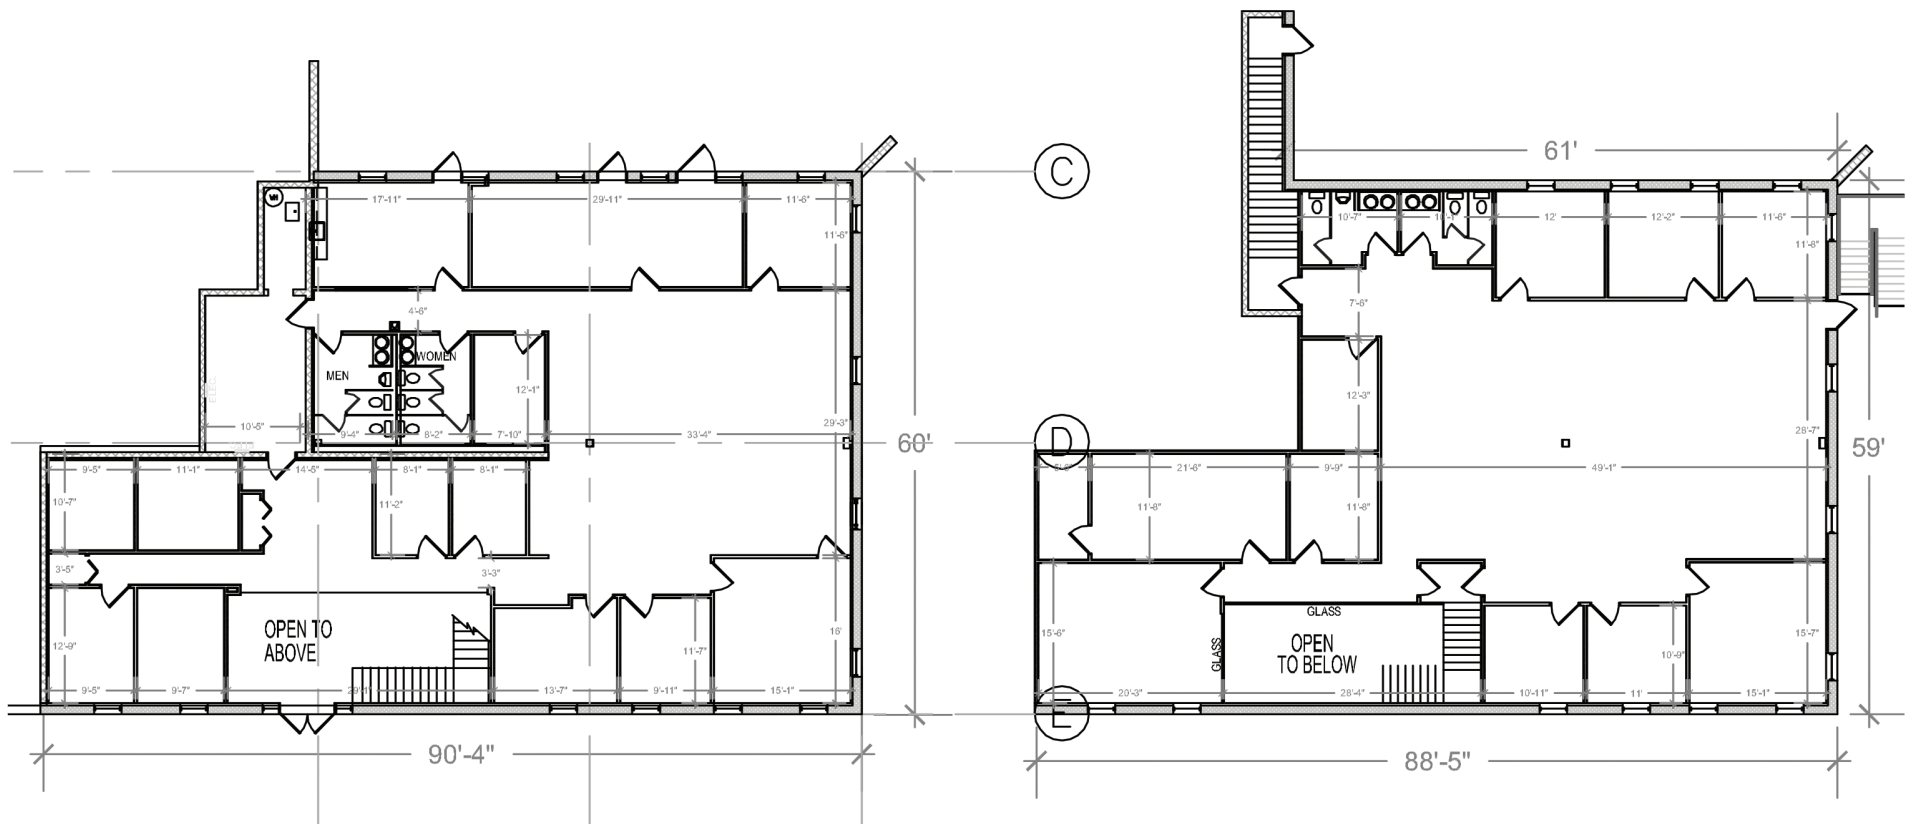

Plan not to scale - this is not a construction document.