



TOTAL SF AVAILABLE - 3,381 SF

OFFICE - 1,137 SF

WAREHOUSE - 2,244 SF

[Click to access 3D model](#)

Key Plan

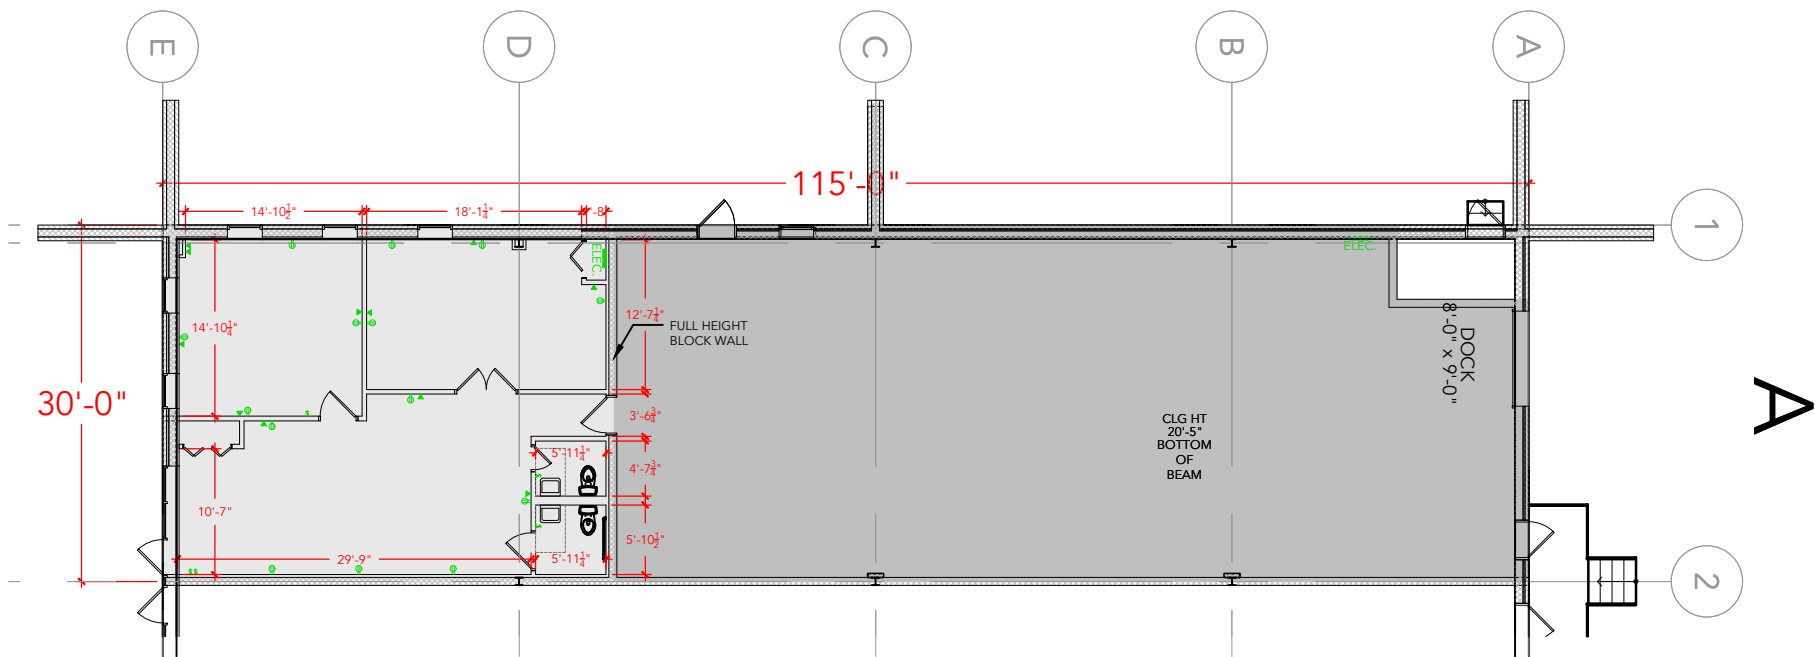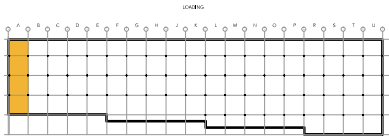

Floor Plan