


TOTAL SF AVAILABLE - 3,450 SF


OFFICE - 0,000 SF

WAREHOUSE SF - 3,450 SF

[Click to access 3D model](#)

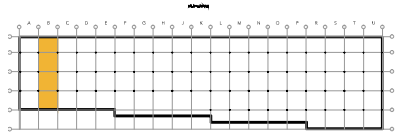

Key Plan

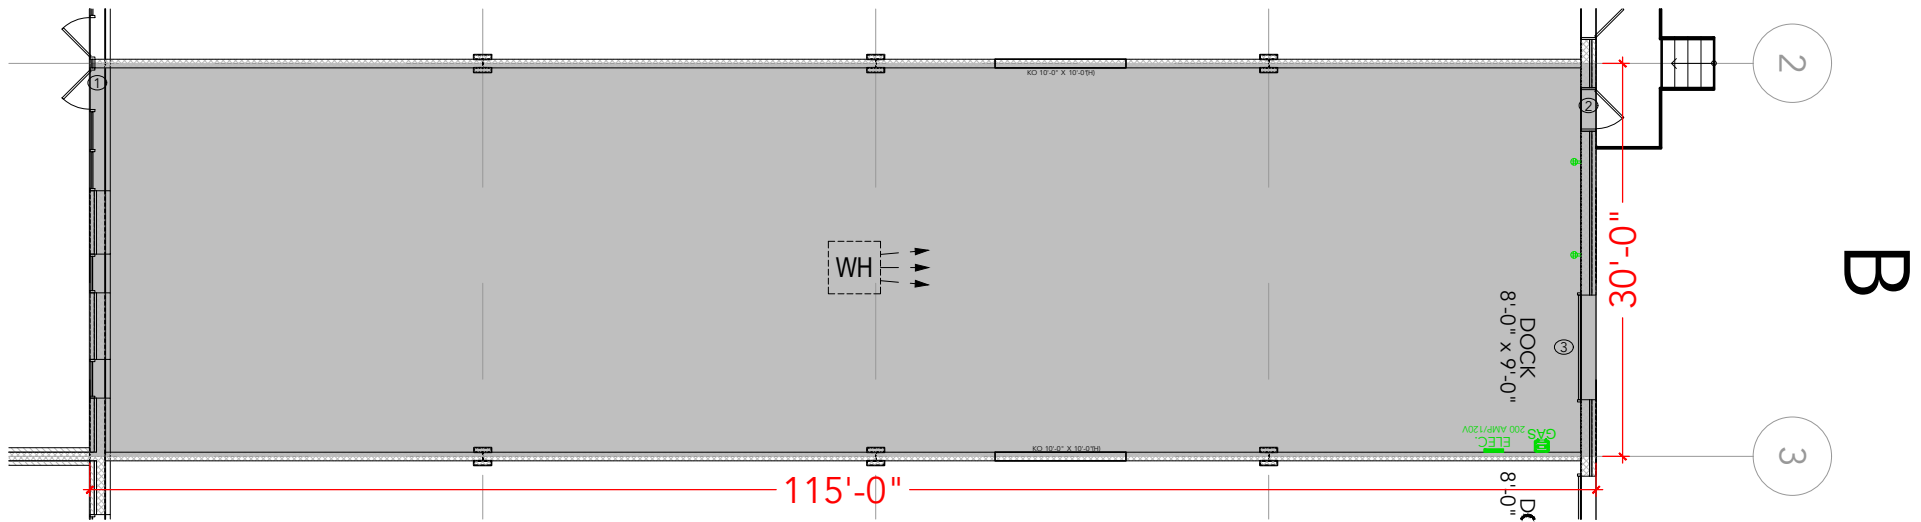

Floor Plan