


TOTAL SF AVAILABLE -3,455 RSF

OFFICE - 0,0000 RSF


WAREHOUSE - 3,455 RSF

* INCLUDES % OF METER ROOM

[Click to access CADD file](#)

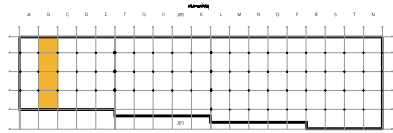

Key Plan

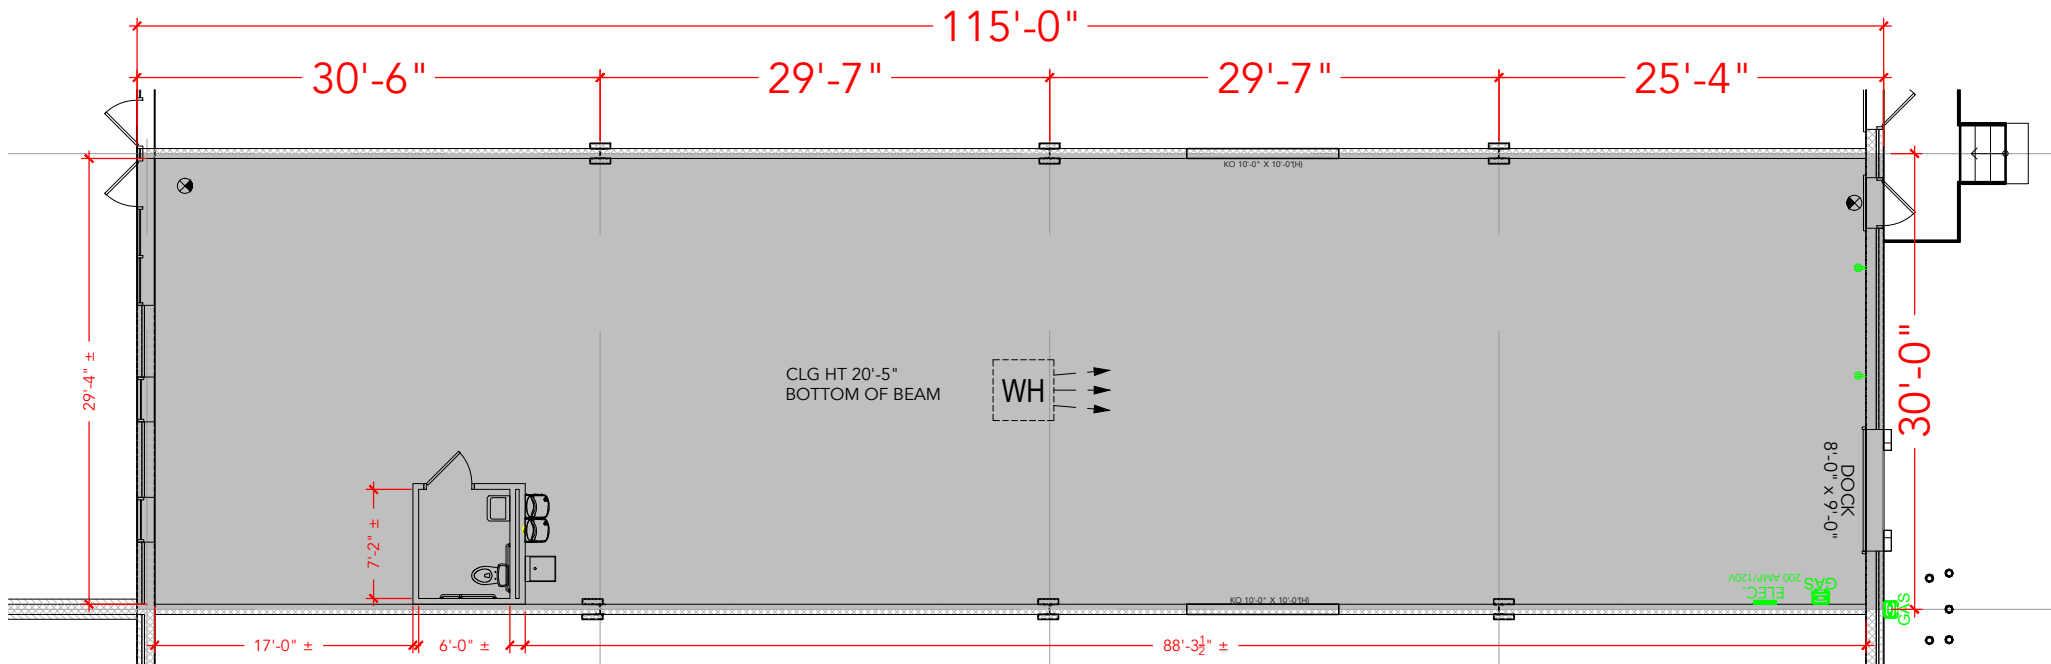

Floor Plan