



**TOTAL SF AVAILABLE - 6,900 SF**

OFFICE - 1,202 SF  
WAREHOUSE - 5,698 SF

[Click to access 3D model](#)

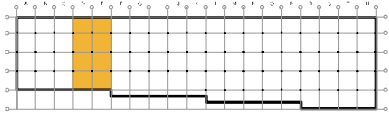

Key Plan

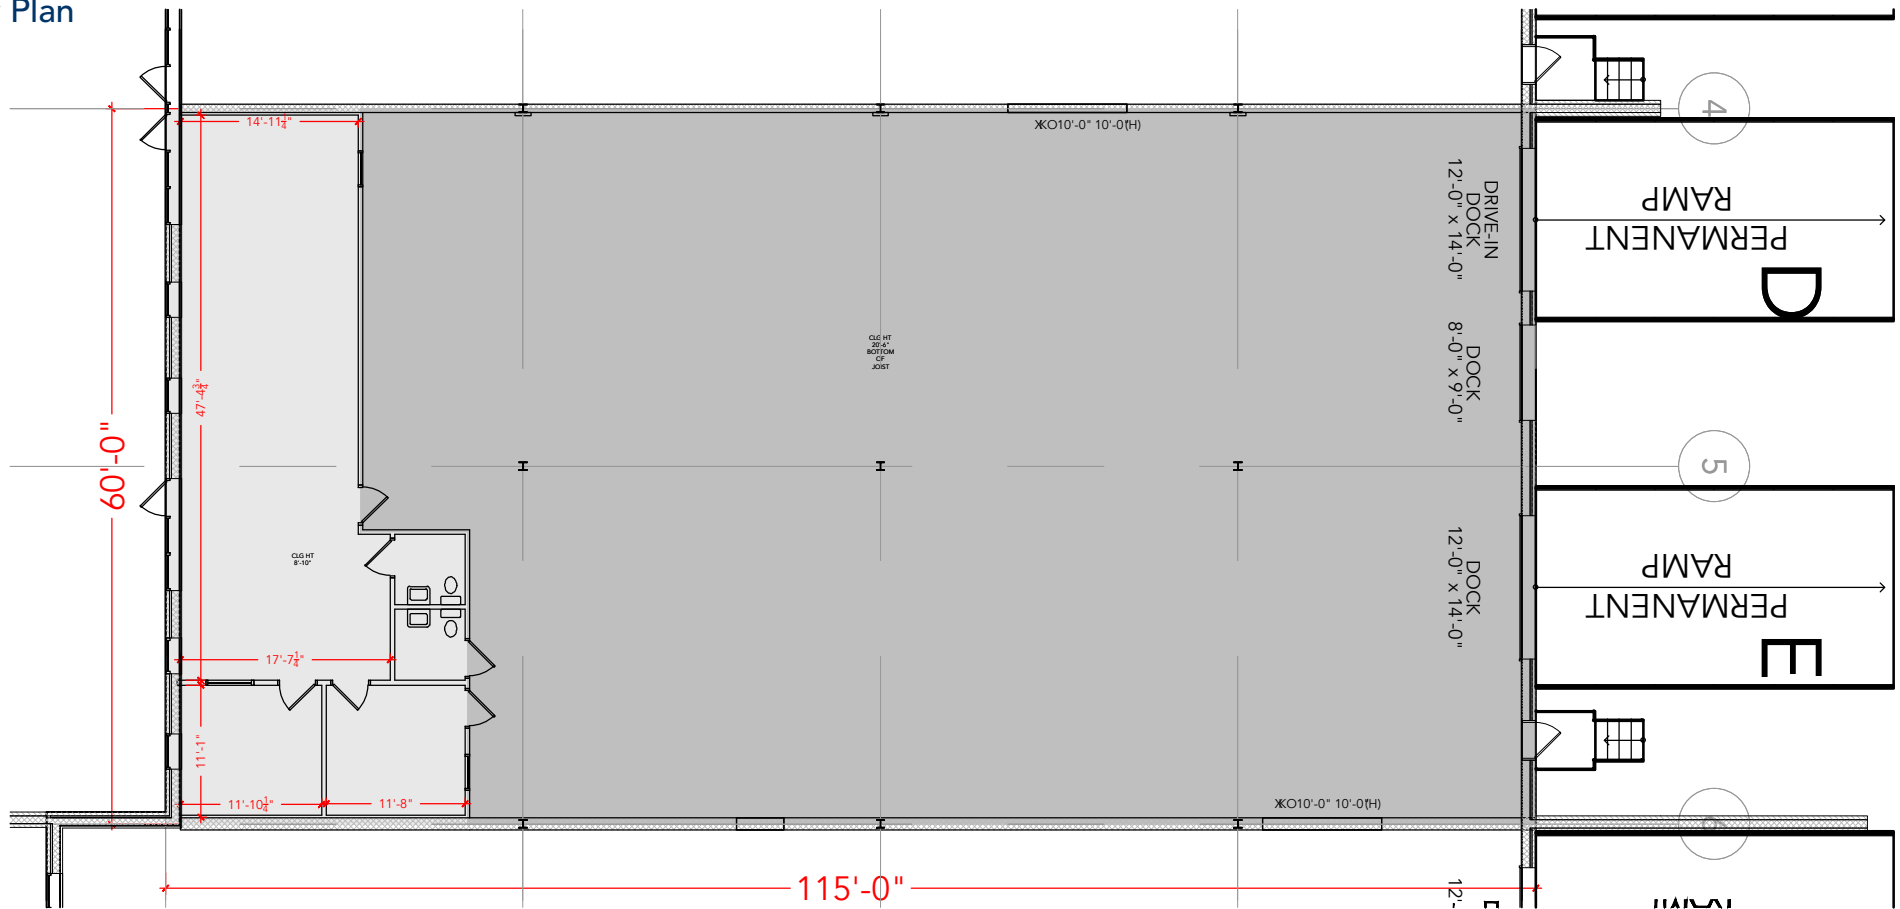

Floor Plan