



**TOTAL SF AVAILABLE - 6,900 SF**

OFFICE - 1,470 SF  
WAREHOUSE - 5,430 SF

[Click to access 3D model](#)

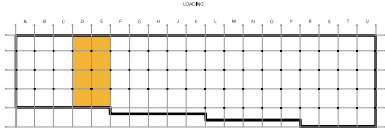

Key Plan

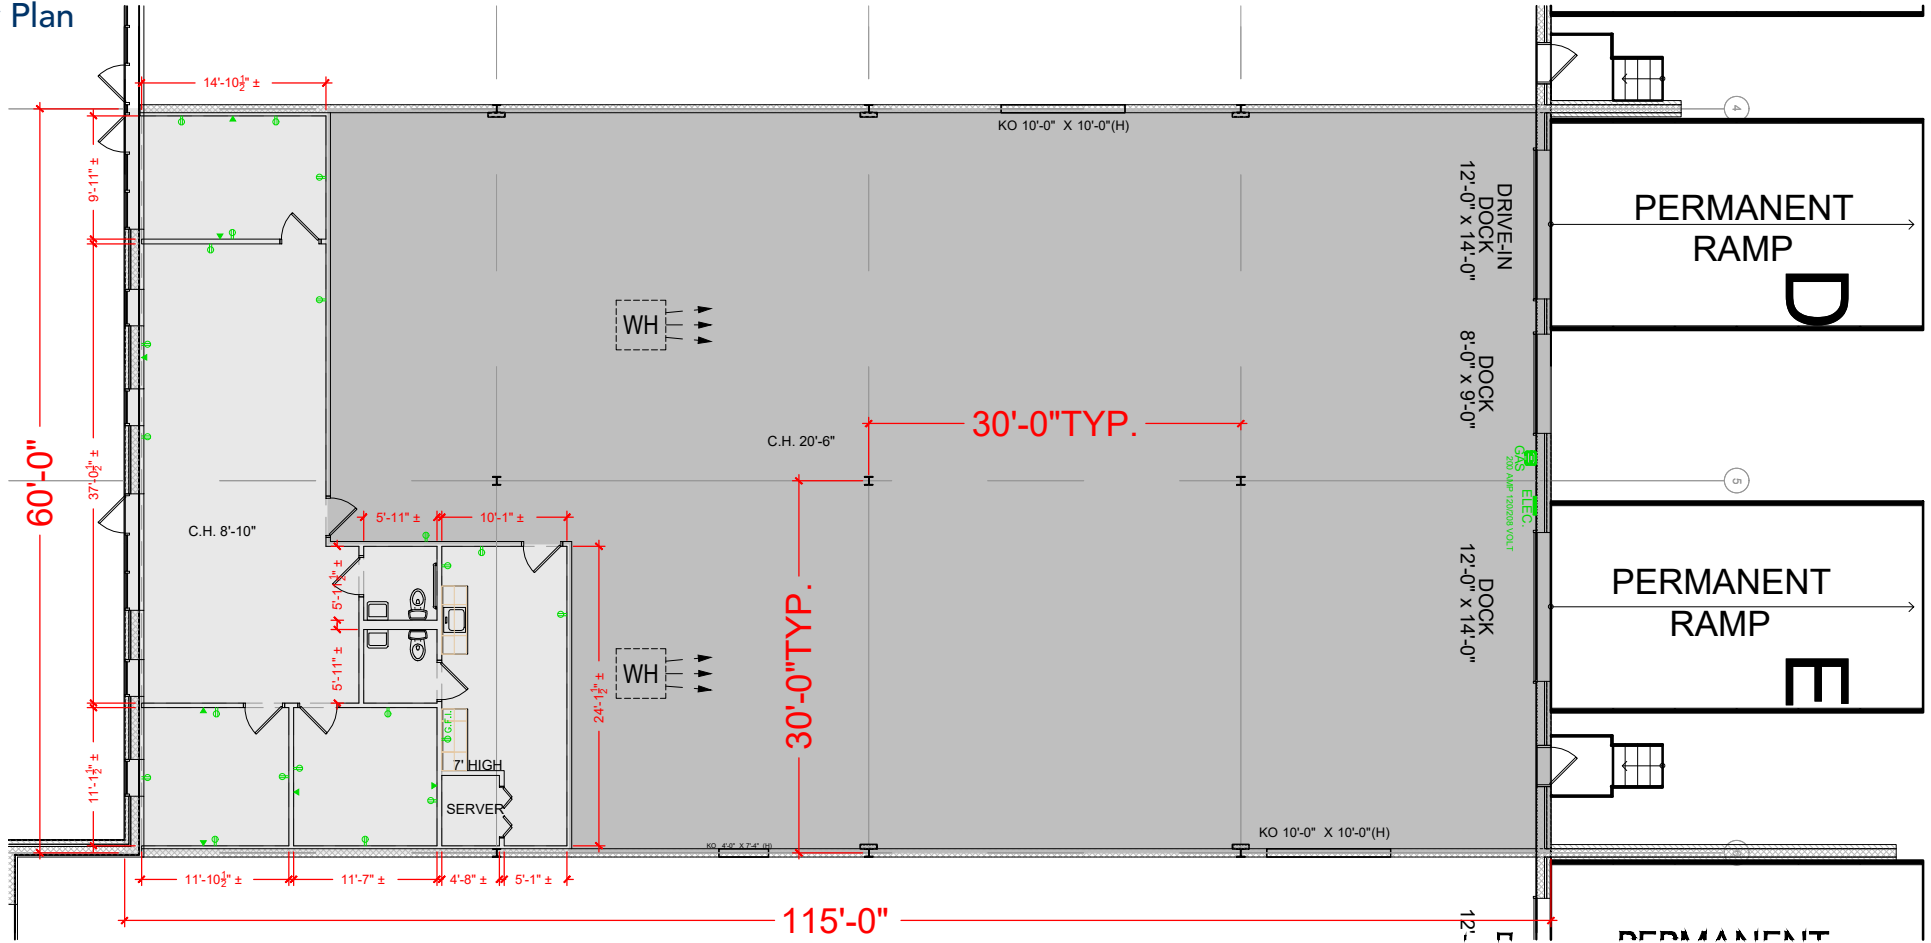

Floor Plan