




Click to access **CADD file**

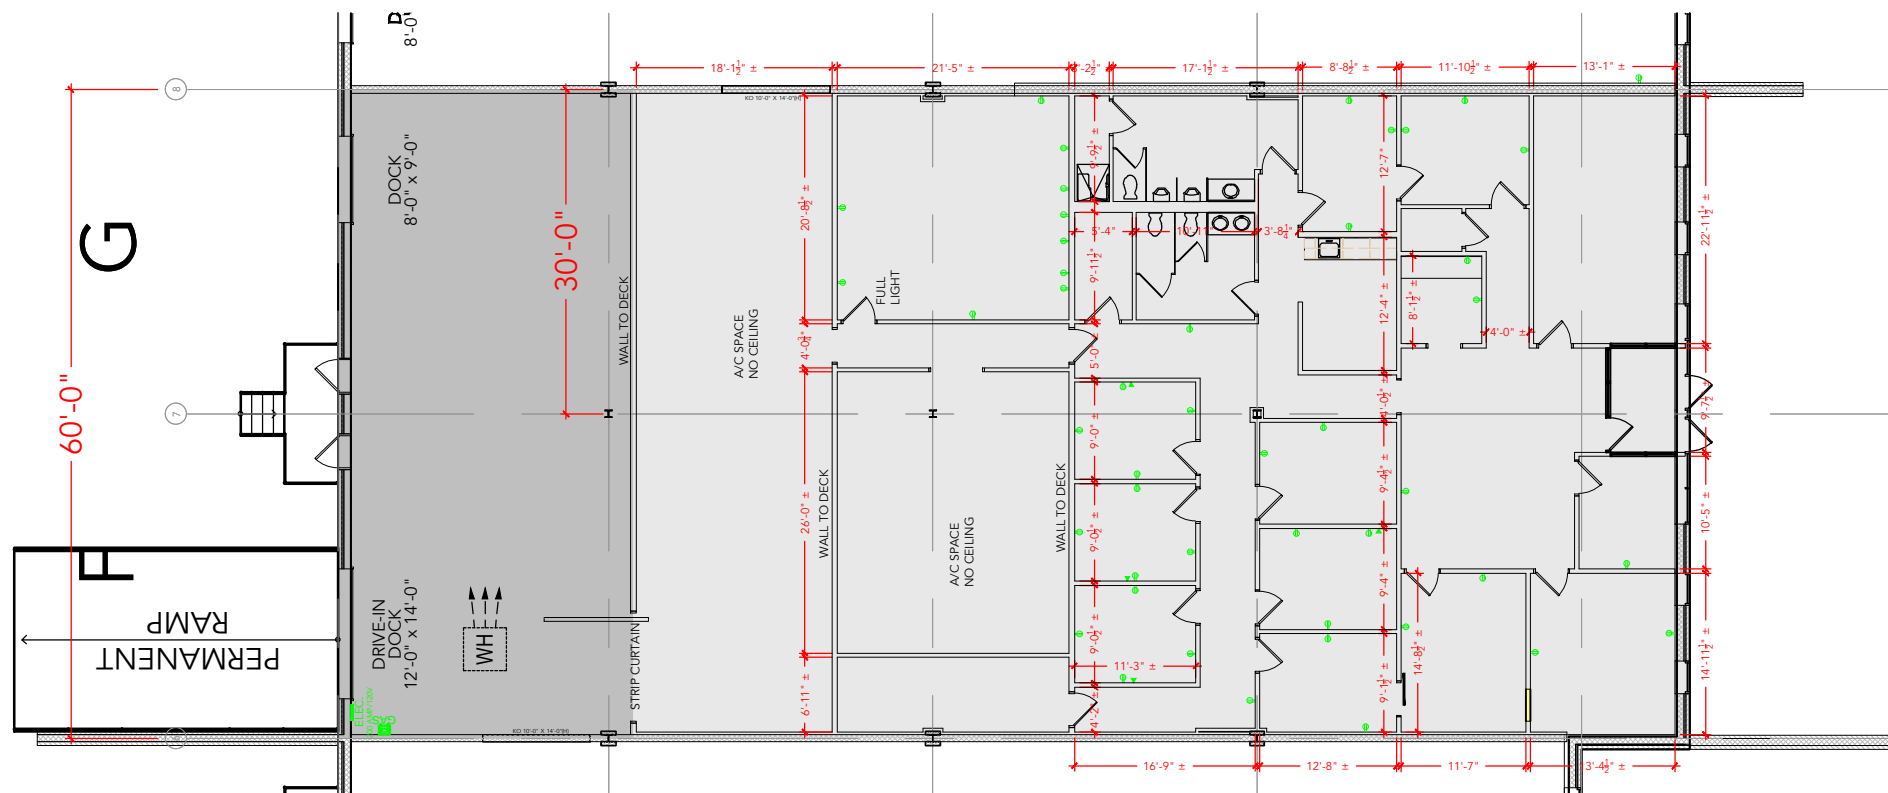

Floor Plan

PLAN NOT TO SCALE - THIS IS NOT A CONSTRUCTION DOCUMENT

DRAWING #: 060-601-F-G

ASBUILT DATE: 01.18.19