


TOTAL SF AVAILABLE -7,512 RSF


OFFICE - 3,427 RSF
WAREHOUSE - 4,085 RSF

* INCLUDES % OF METER ROOM

[Click to access CADD file](#)

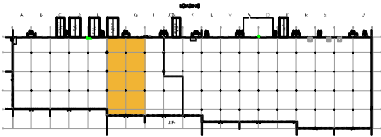

Key Plan

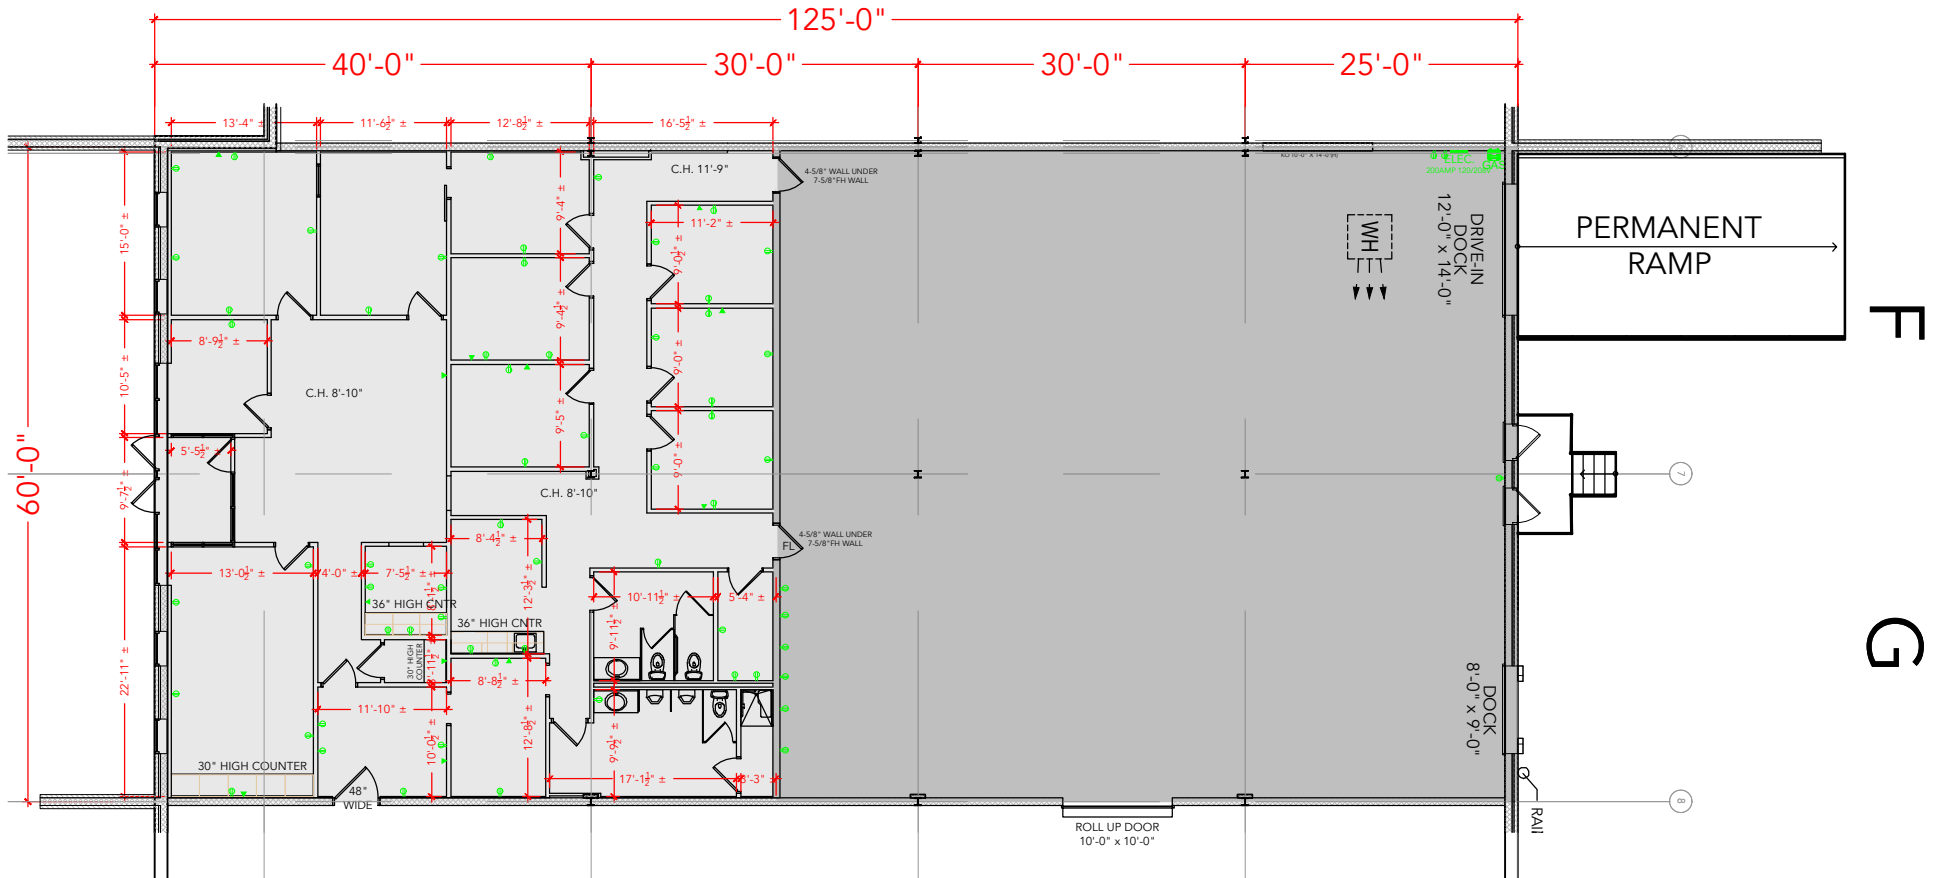

Floor Plan