


TOTAL SF AVAILABLE -5,625 SF


OFFICE - 3,755 SF

WAREHOUSE - 1,871 SF

[Click to access CADD file](#)

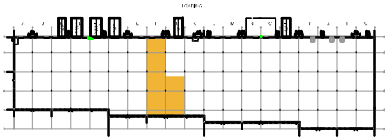

Key Plan

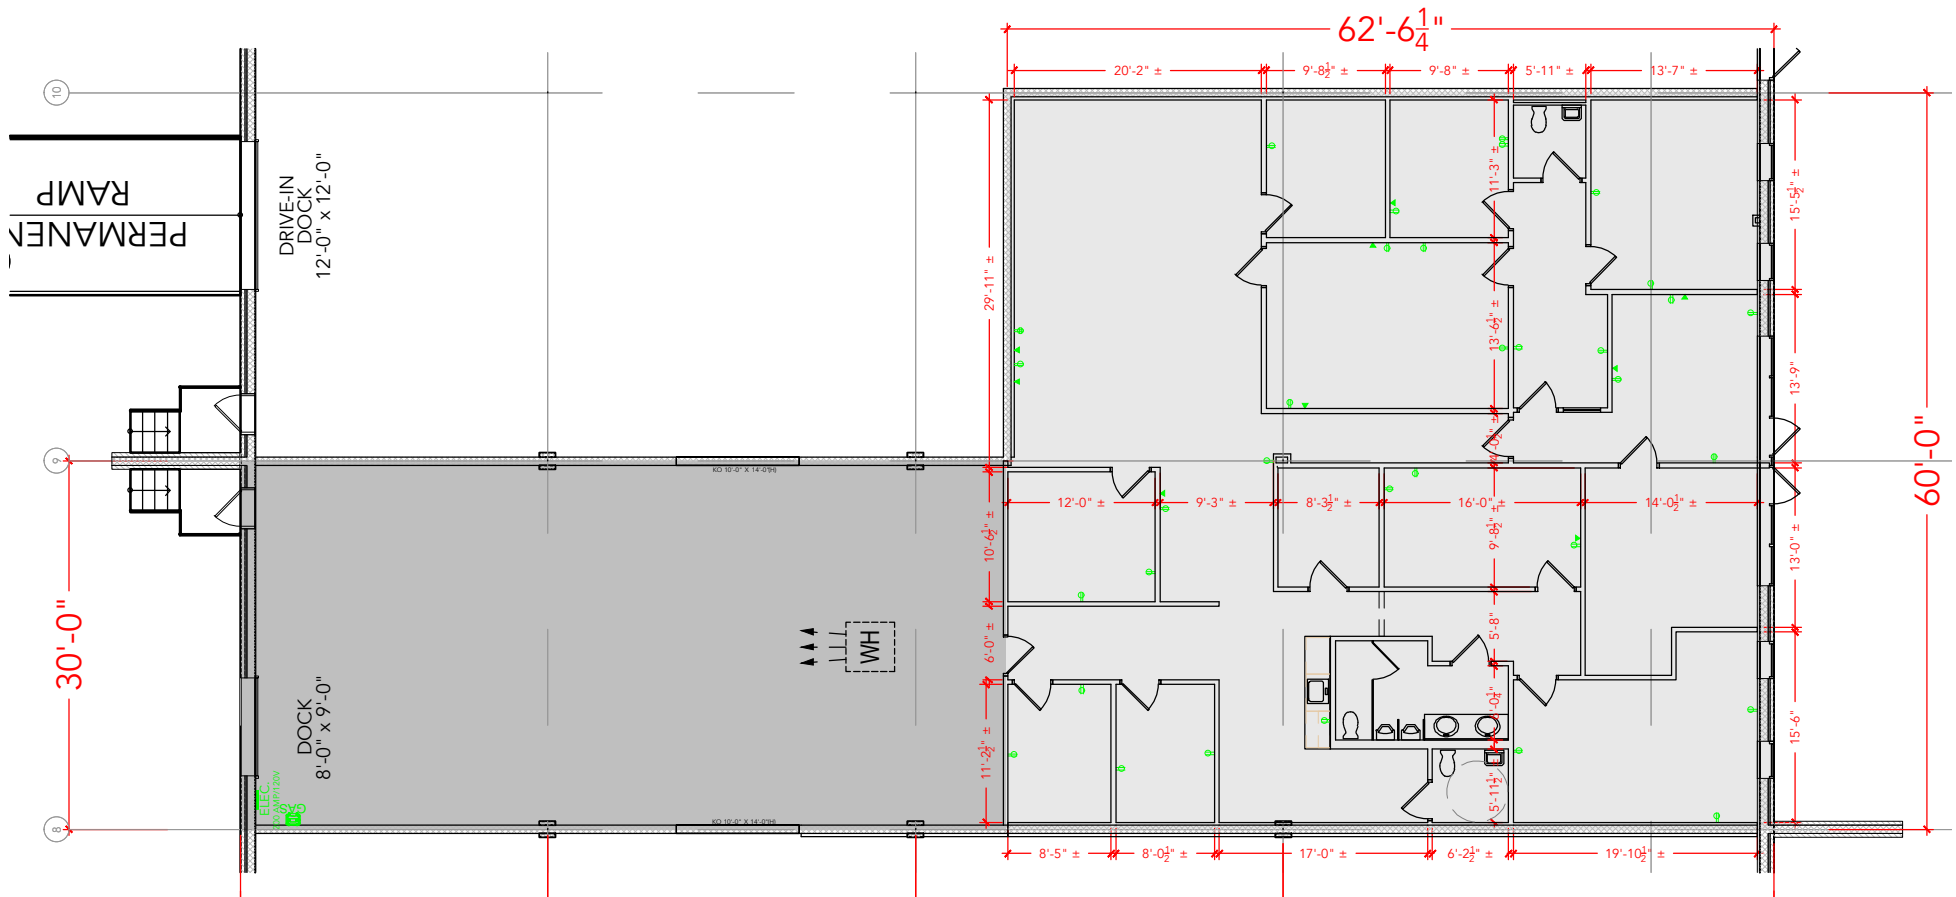

Floor Plan