


**TOTAL SF AVAILABLE -8,112 RSF**

**OFFICE - 924 RSF**


**WAREHOUSE - 7,188 RSF**

\* INCLUDES % OF METER ROOM

[Click to access CADD file](#)

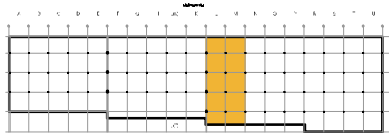

Key Plan

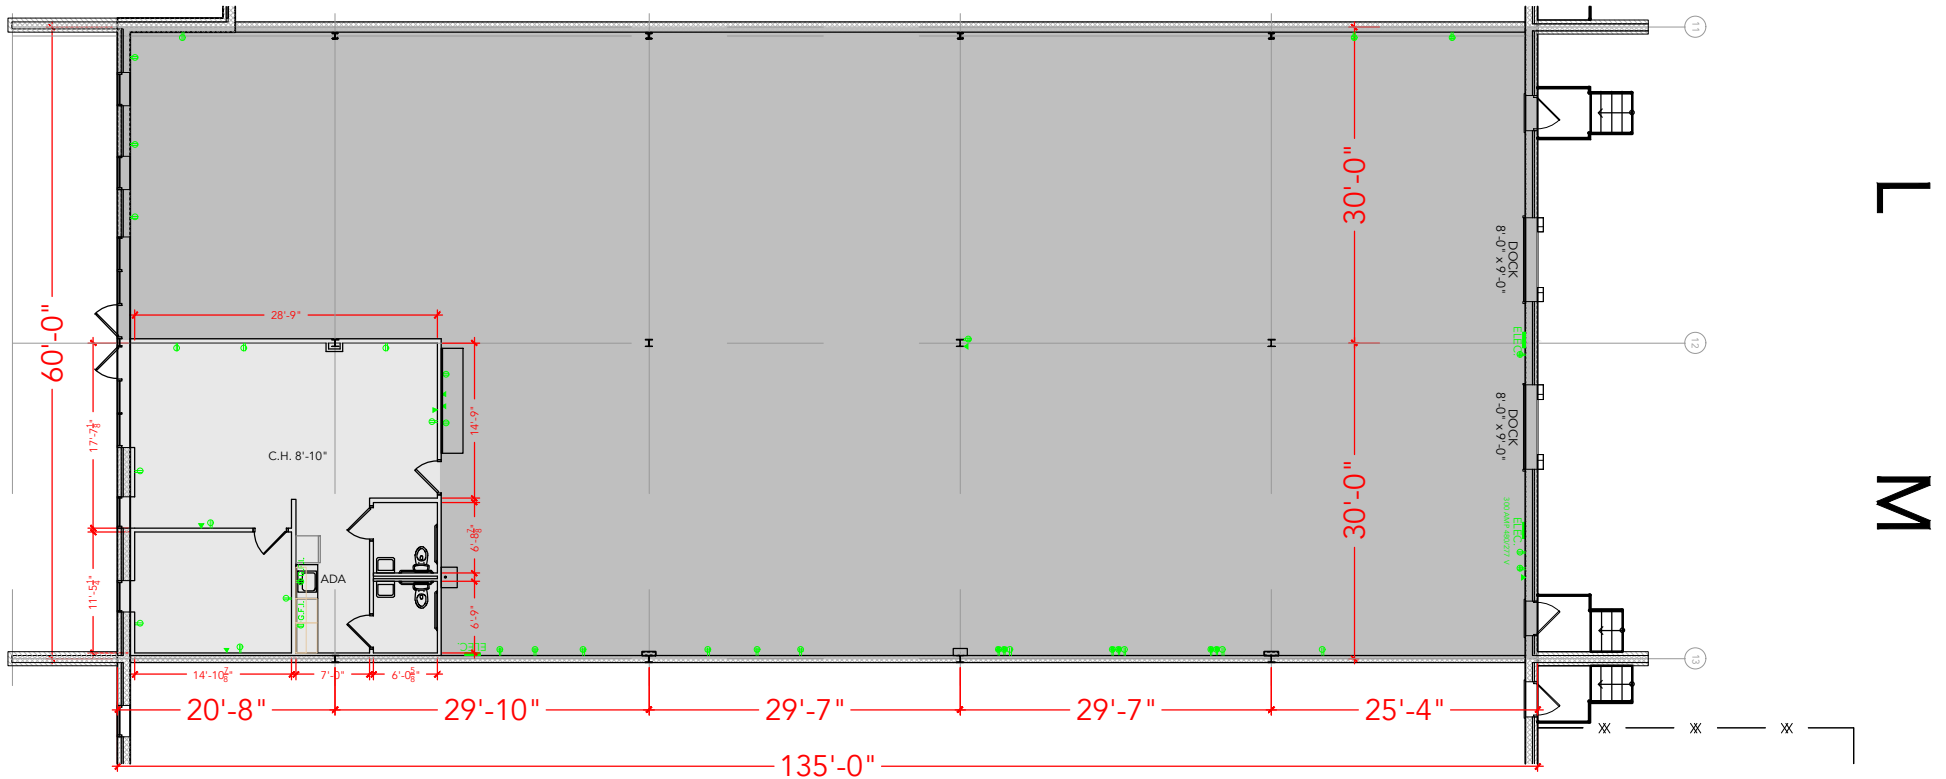

Floor Plan