


**TOTAL SF AVAILABLE - 25,430 SF**


**OFFICE - 8,468 SF**

**WAREHOUSE - 16,962 SF**

[Click to access CADD file](#)

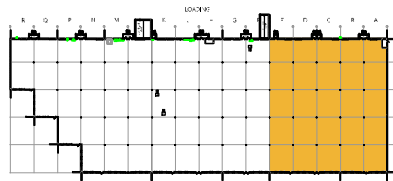

Key Plan

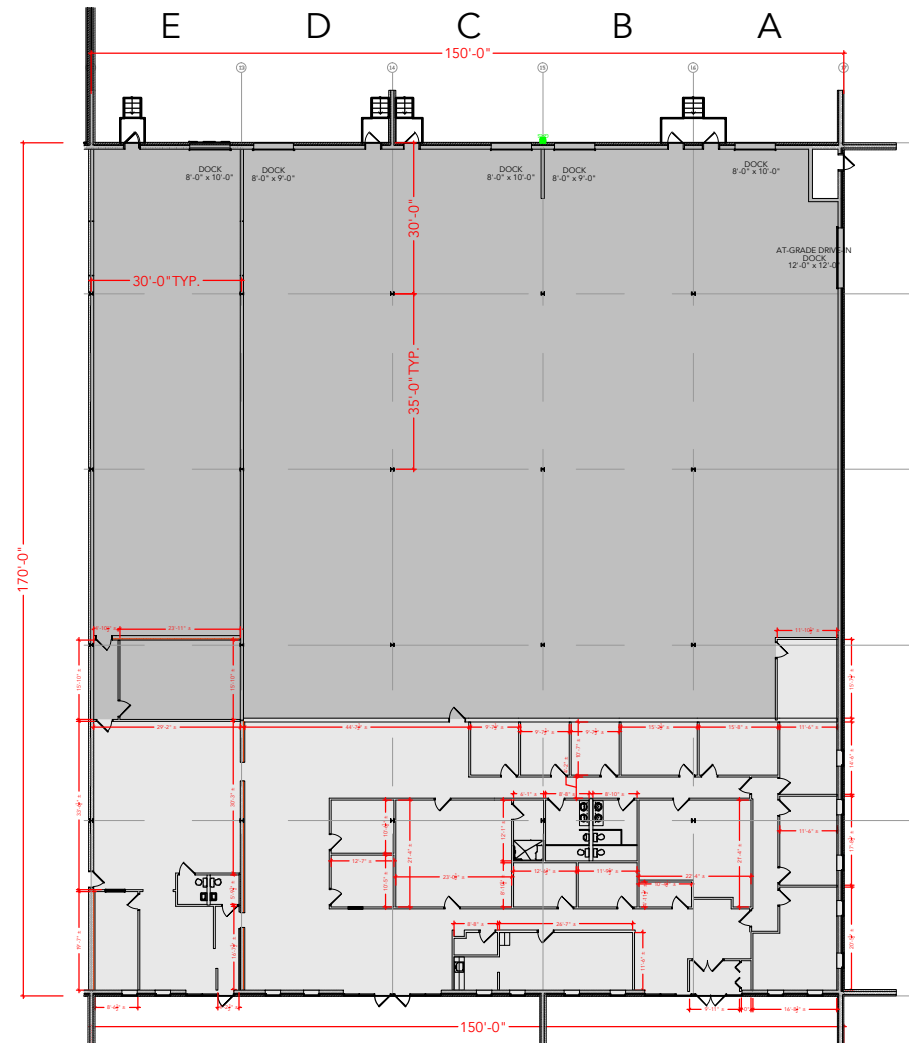

Floor Plan