


**TOTAL SF AVAILABLE - 10,140 SF**


**OFFICE - 370 SF**

**WAREHOUSE SF - 9,770 SF**

[Click to access 3D model](#)

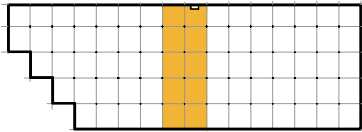

Key Plan

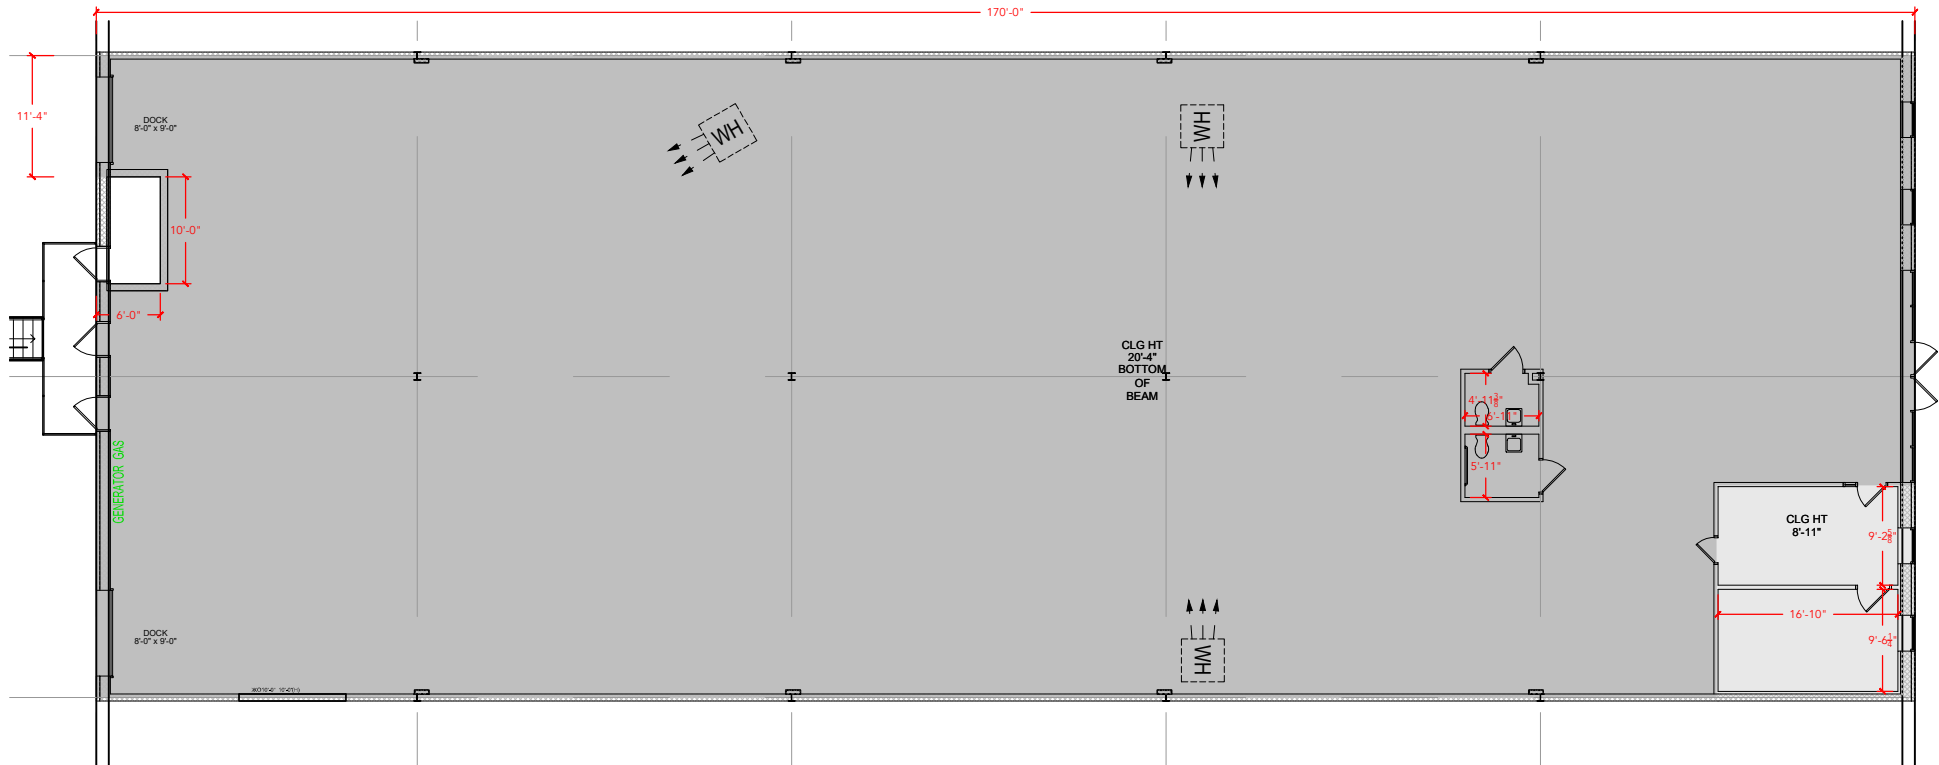

Floor Plan