


**TOTAL SF AVAILABLE - 5,100 SF**


OFFICE - 1,686 SF

WAREHOUSE - 3,415 SF

[Click to access 3D model](#)

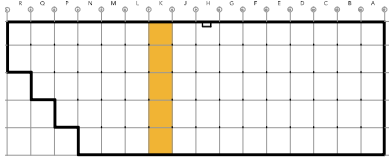

Key Plan

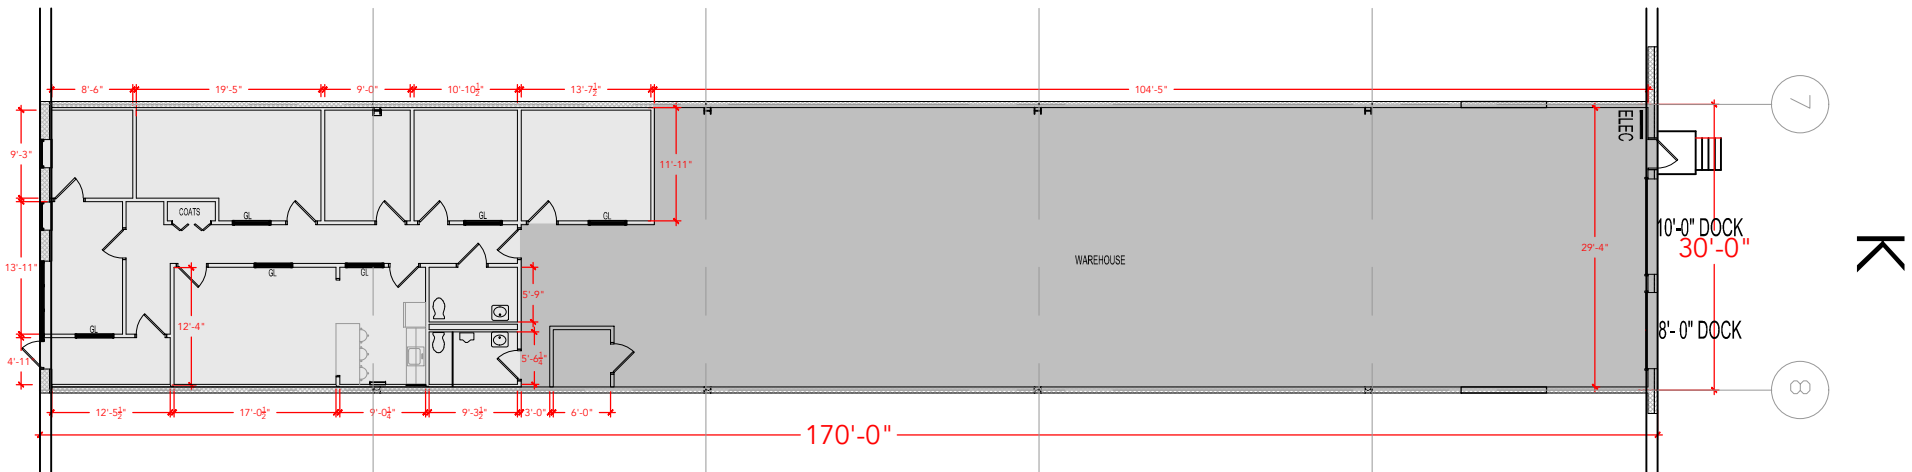

Floor Plan