



TOTAL SF AVAILABLE - 4,050 SF

OFFICE - 2,347 SF
WAREHOUSE SF - 1,703 SF

[Click to access 3D model](#)

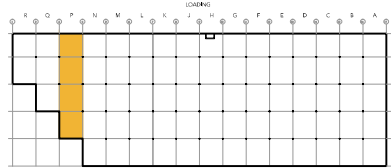

Key Plan

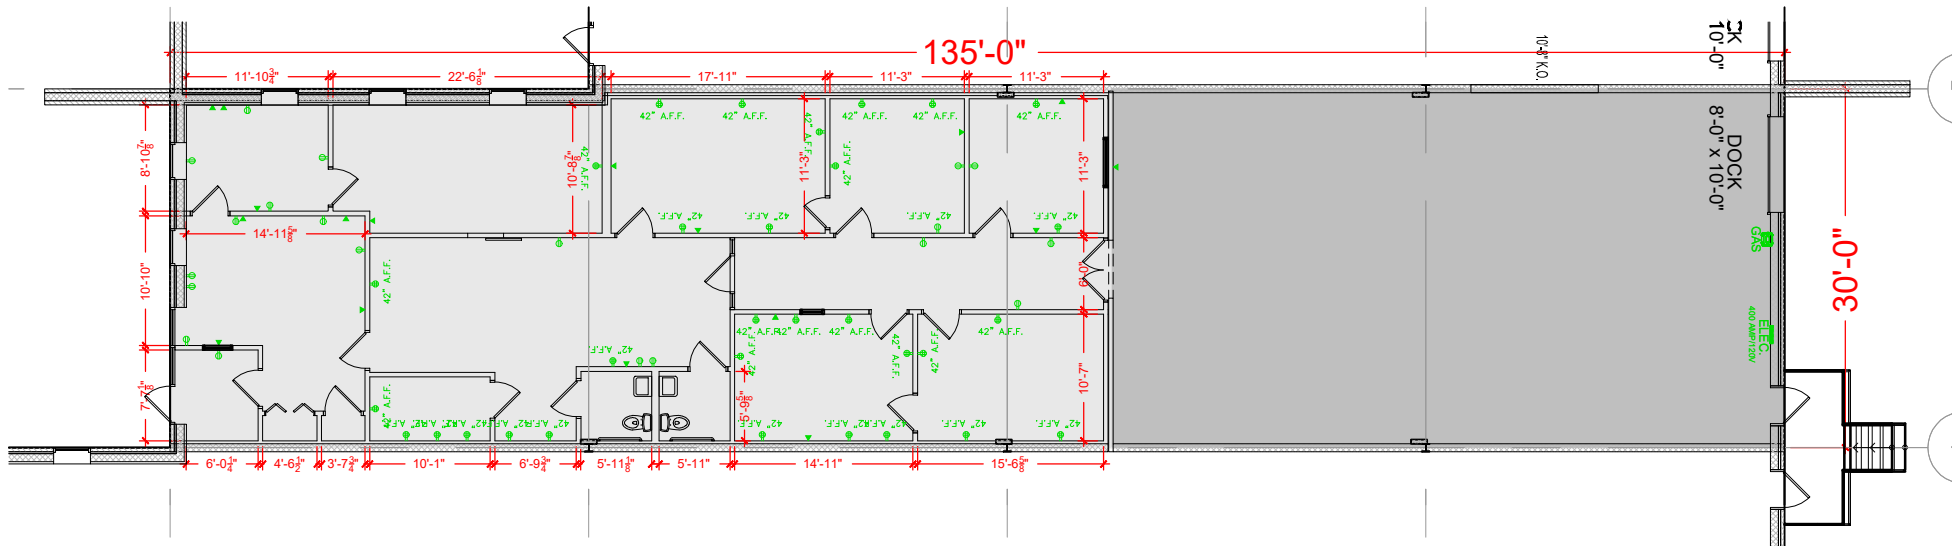

Floor Plan