



**TOTAL SF AVAILABLE -3,000 SF**

OFFICE - 1,617 SF  
WAREHOUSE - 1,383 SF

[Click to access 3D model](#)

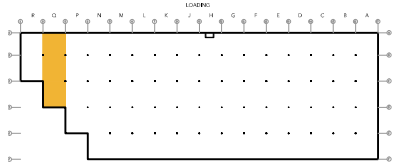

Key Plan

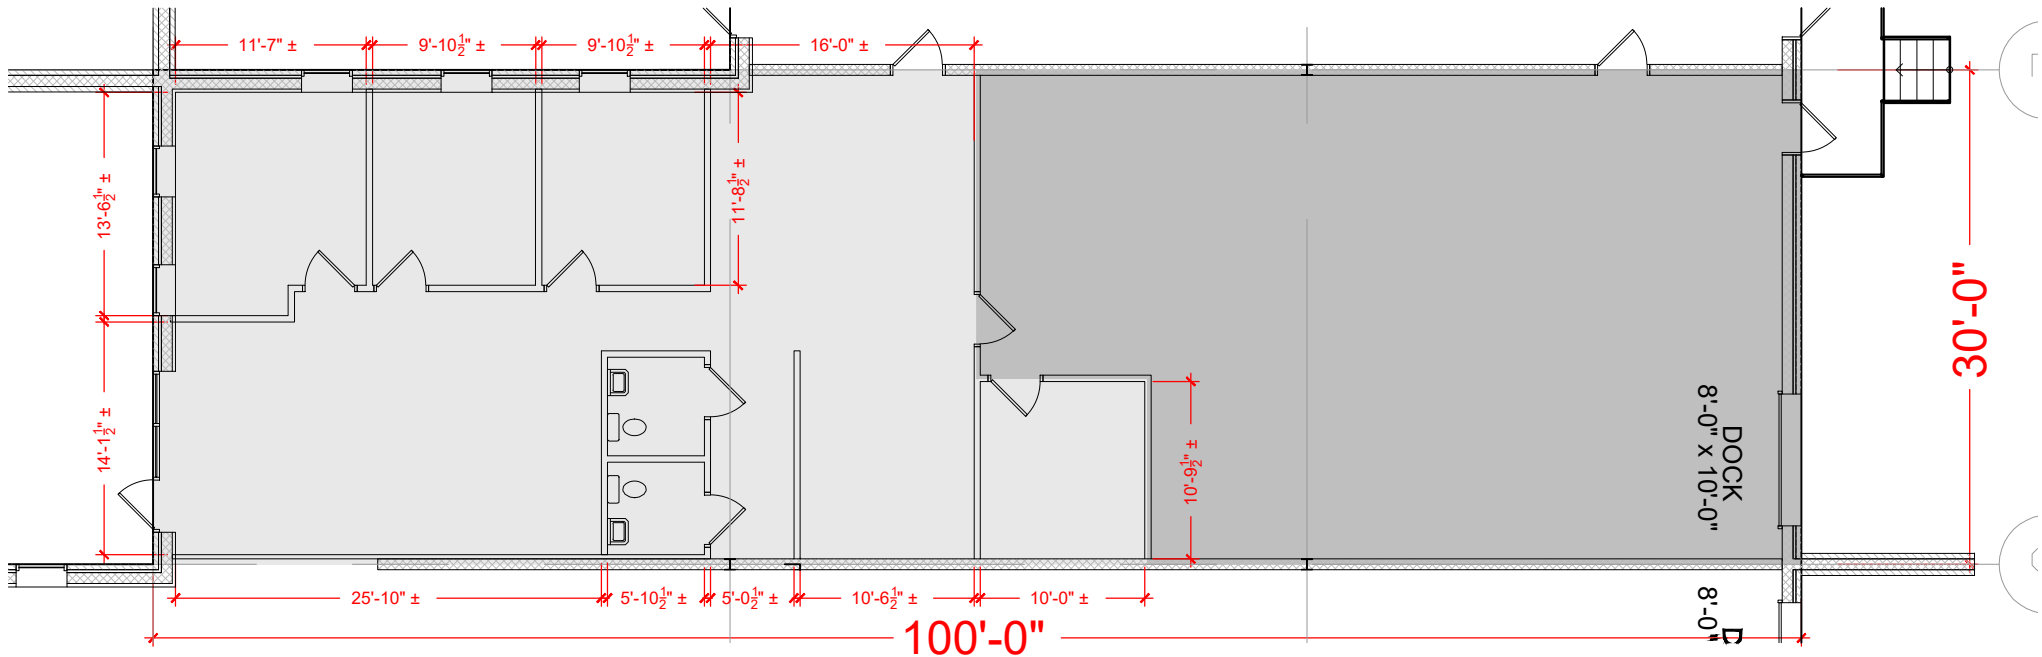

Floor Plan