



TOTAL SF AVAILABLE - 4,950 SF

OFFICE - 2,252 SF
WAREHOUSE - 2,698 SF

[Click to access 3D model](#)

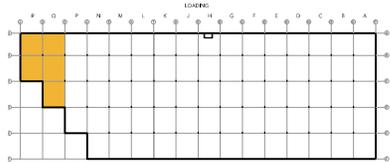

Key Plan

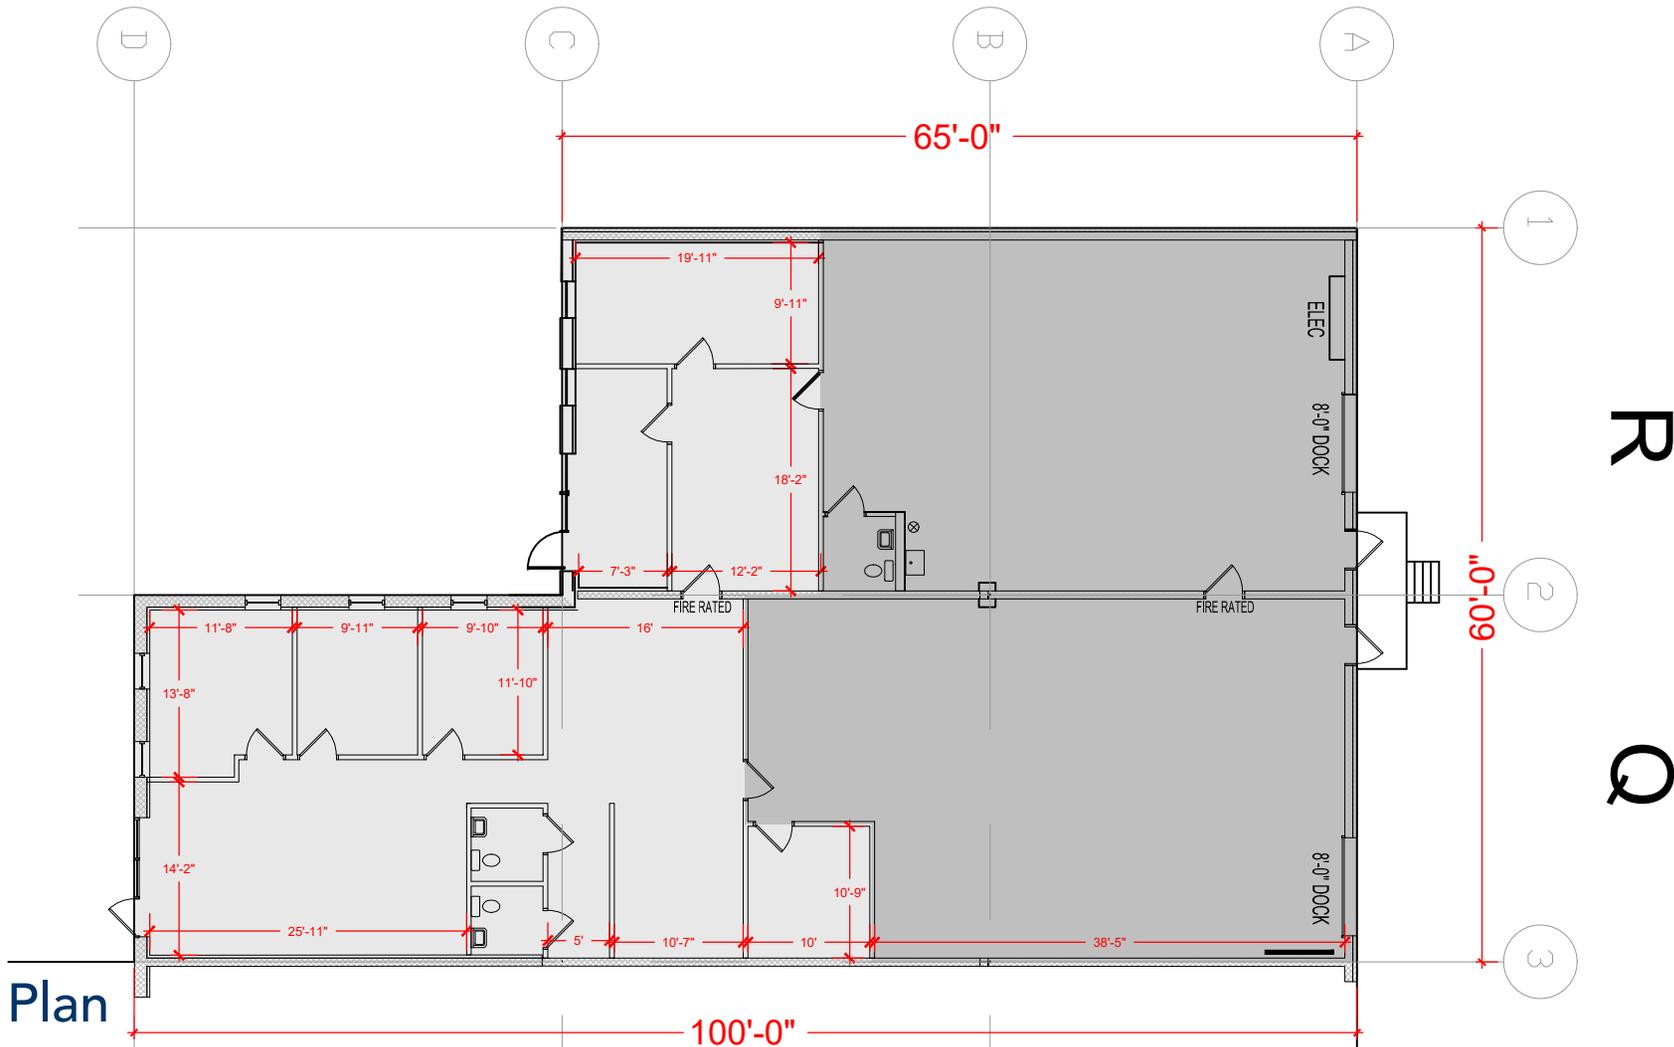

Floor Plan