


**TOTAL SF AVAILABLE - 7,200 SF**


OFFICE - 2,729 SF

WAREHOUSE - 4,471 SF

[Click to access 3D model](#)

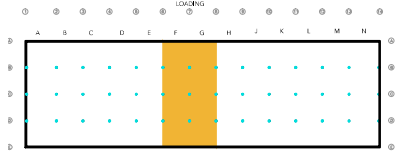

Key Plan

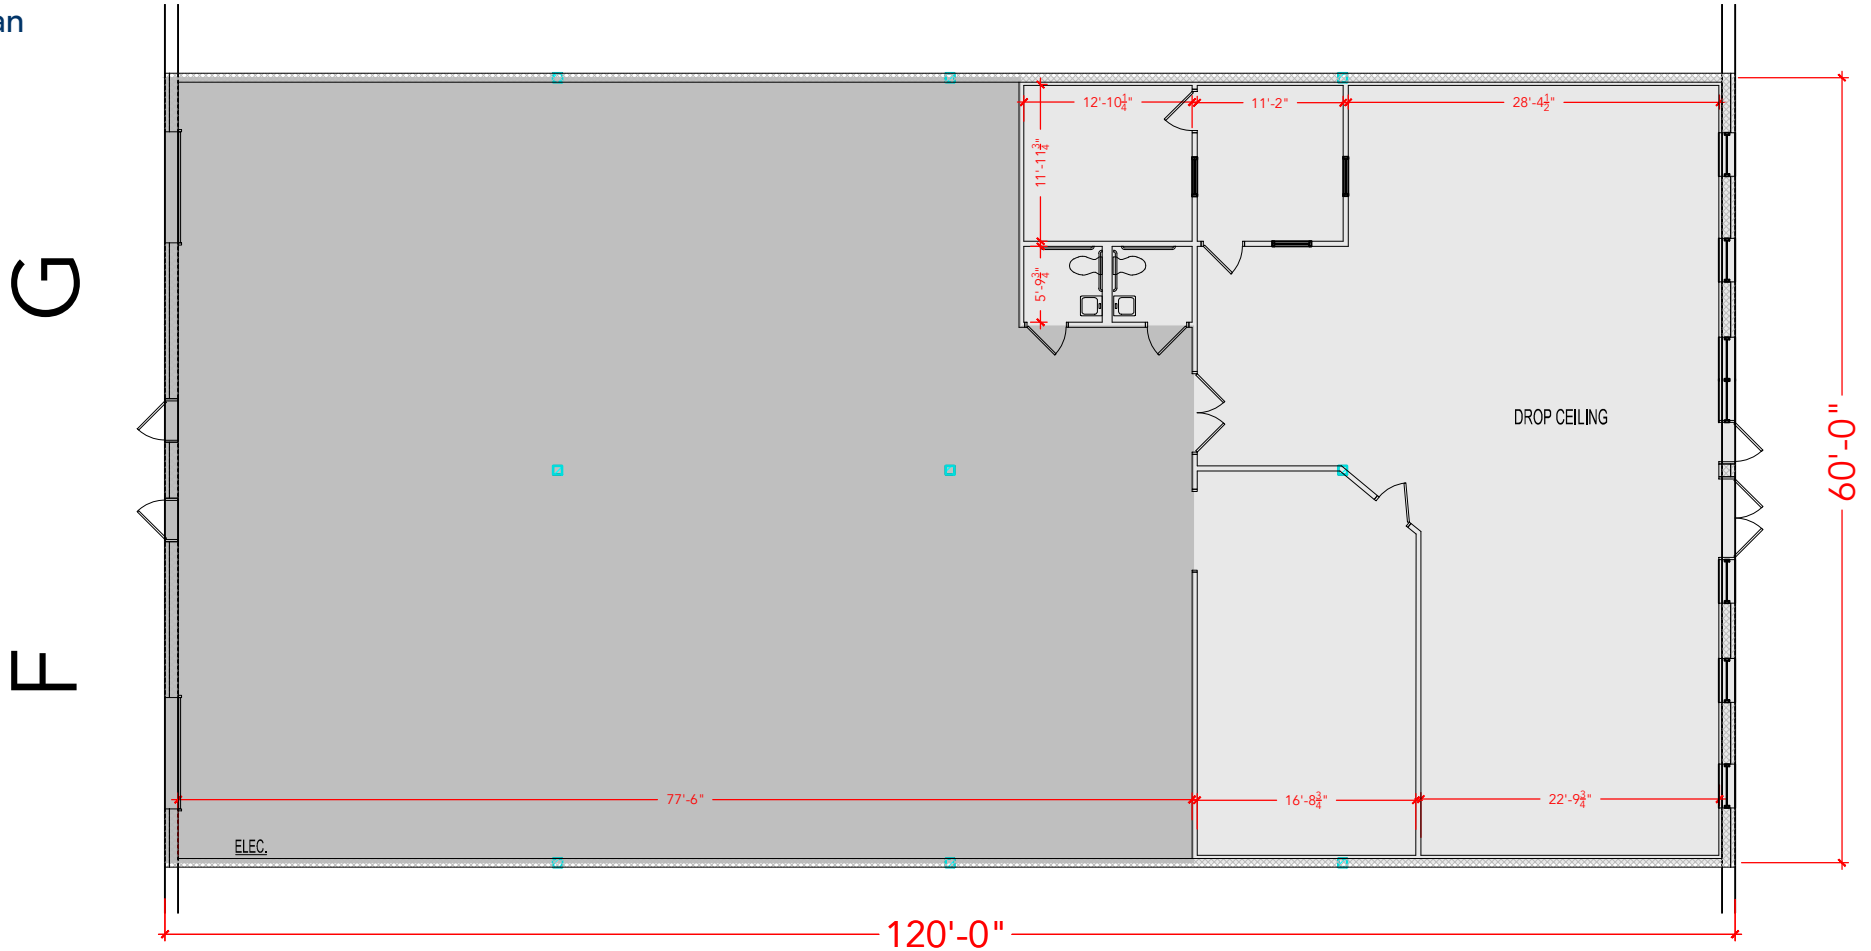

Floor Plan