


TOTAL SF AVAILABLE - 3,600 SF


OFFICE - 1,110 SF

WAREHOUSE - 2,490 SF

[Click to access 3D model](#)

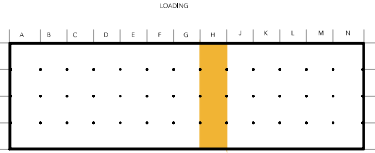

Key Plan

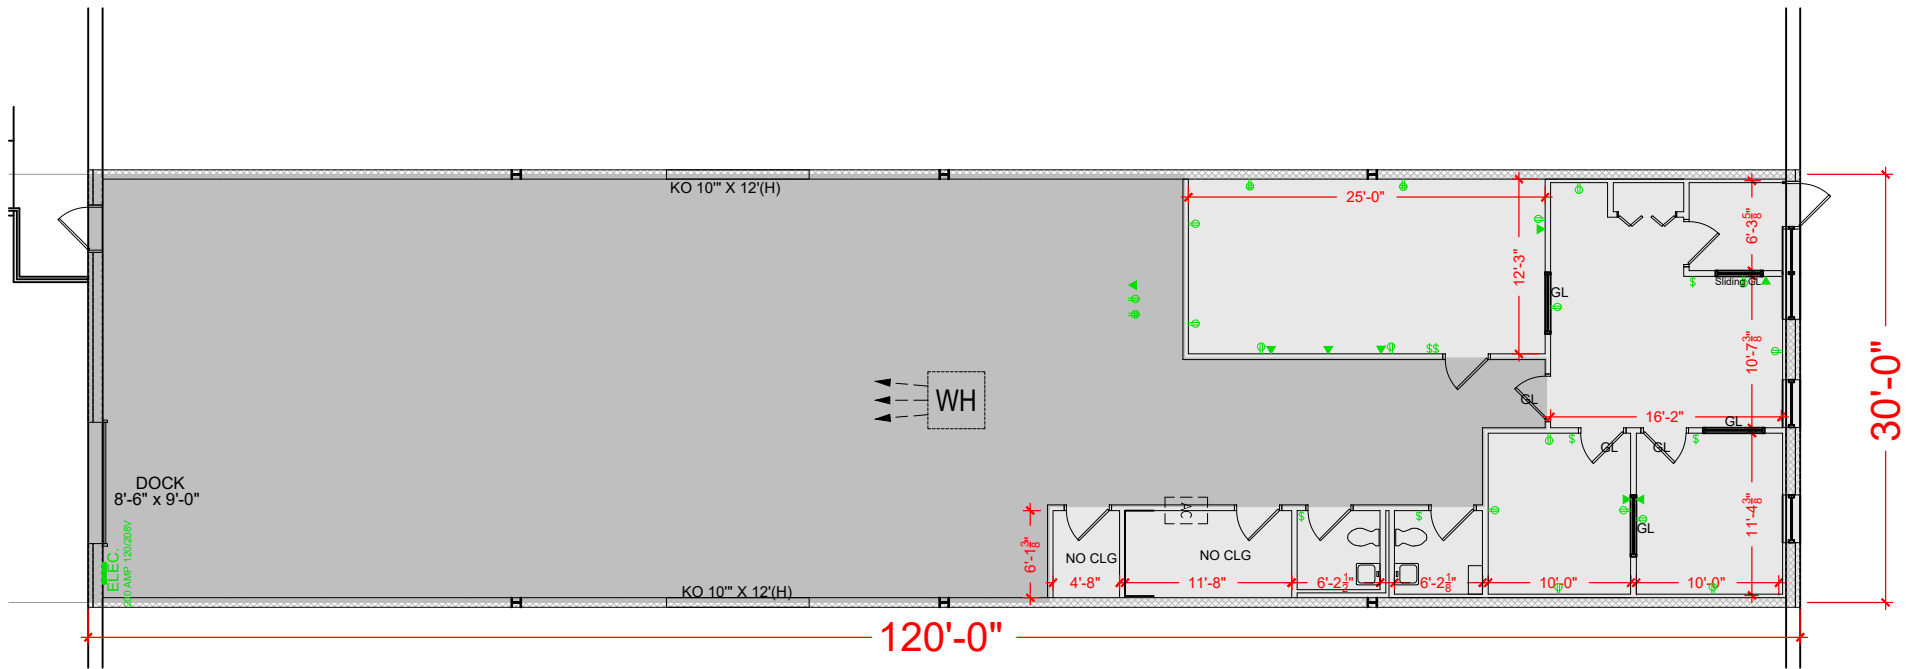

Floor Plan