



**TOTAL SF AVAILABLE - 3,600 SF**

OFFICE - 1,386 SF  
WAREHOUSE - 2,214 SF

[Click to access 3D model](#)

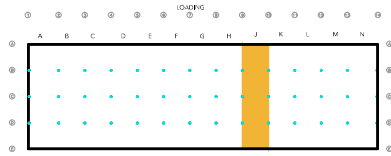

Key Plan

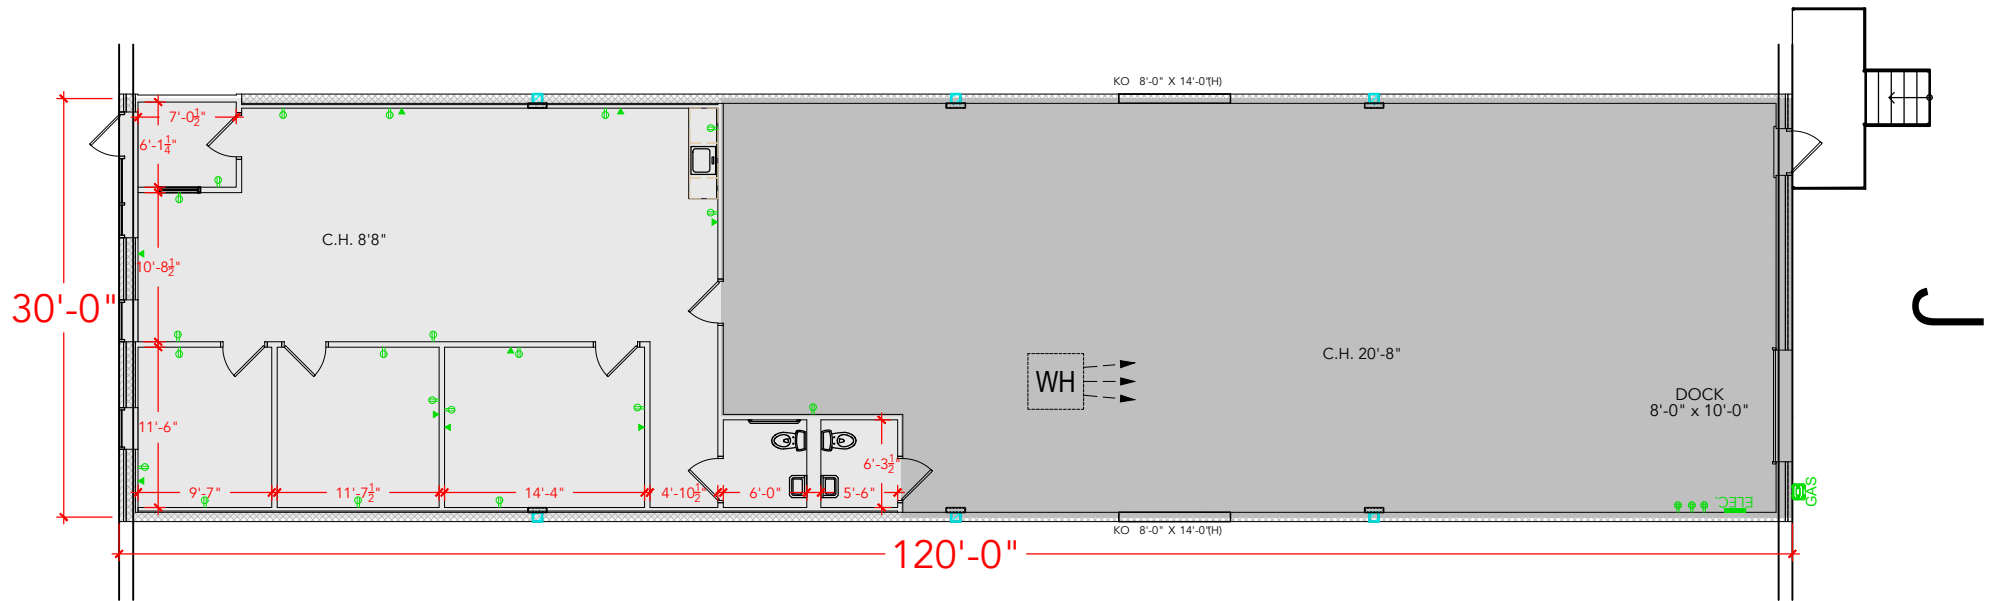

Floor Plan