



TOTAL SF AVAILABLE - 7,800 SF

OFFICE - 3,900 SF
WAREHOUSE - 3,900 SF

[Click to access 3D model](#)

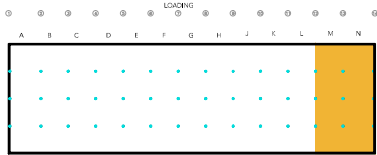

Key Plan

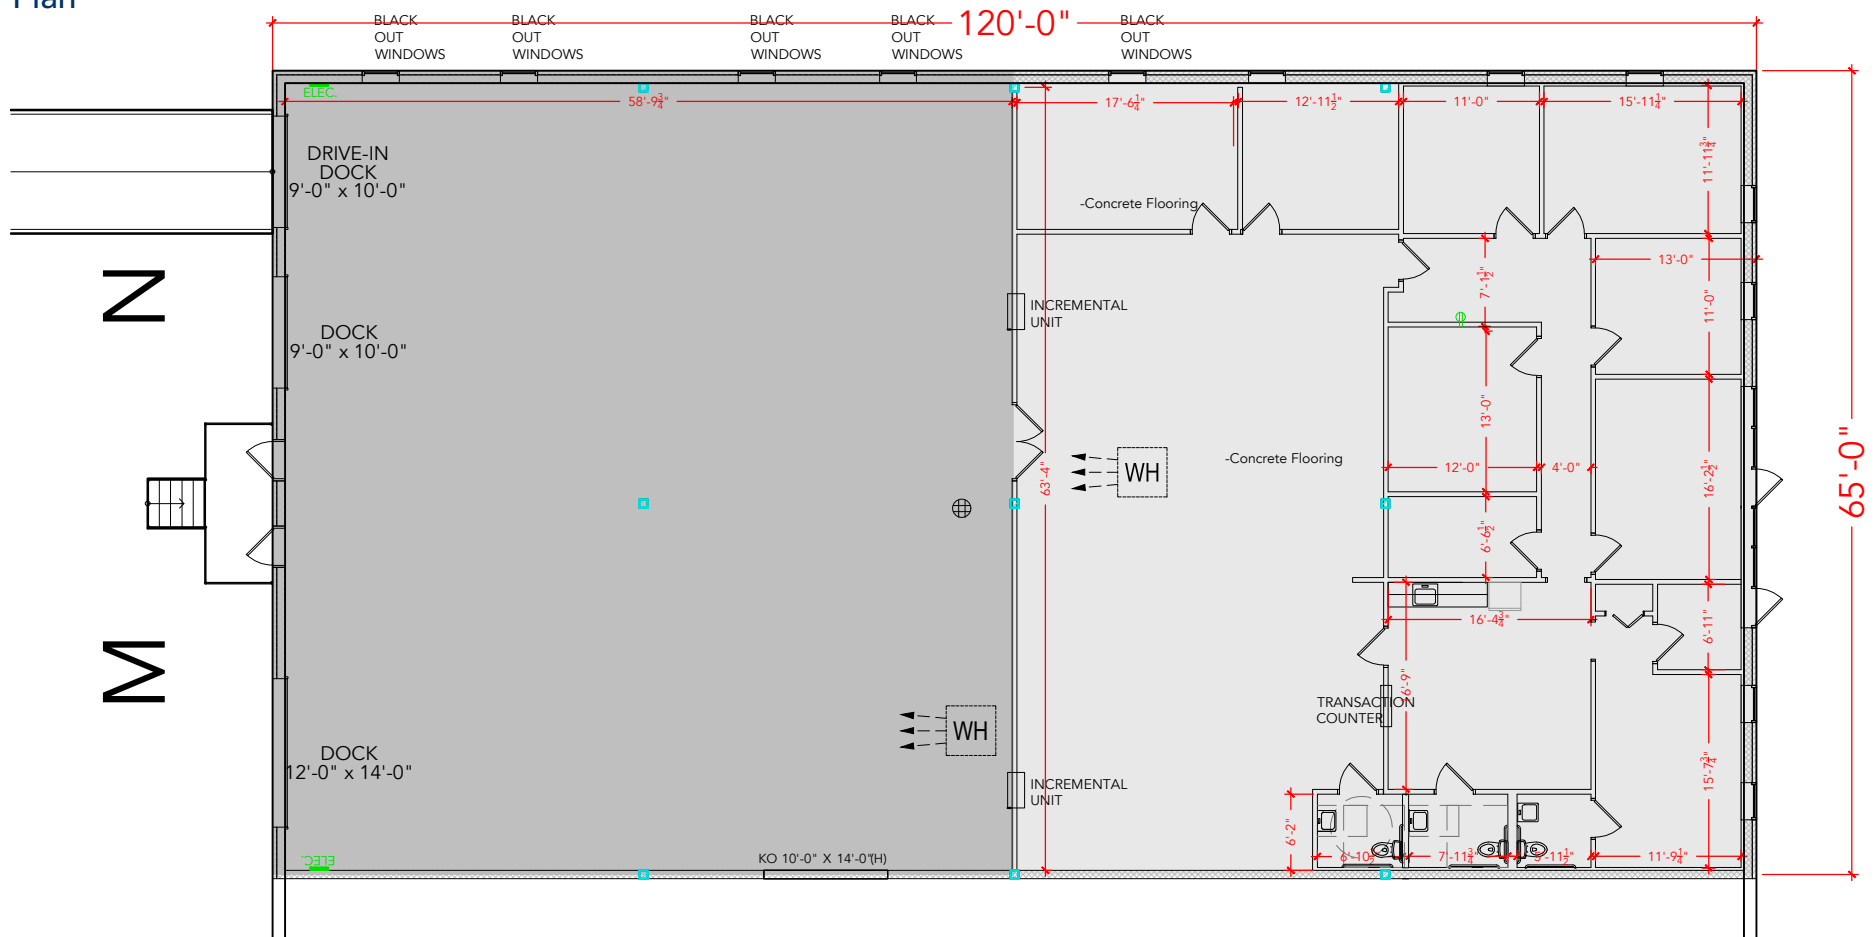

Floor Plan