


TOTAL SF AVAILABLE -47,768 RSF

OFFICE - 4,101 RSF


WAREHOUSE - 43,687 RSF

* INCLUDES % OF METER ROOM

[Click to access CADD file](#)

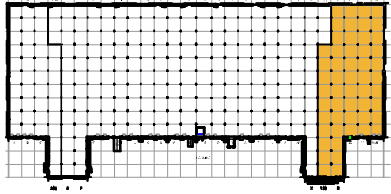

Key Plan

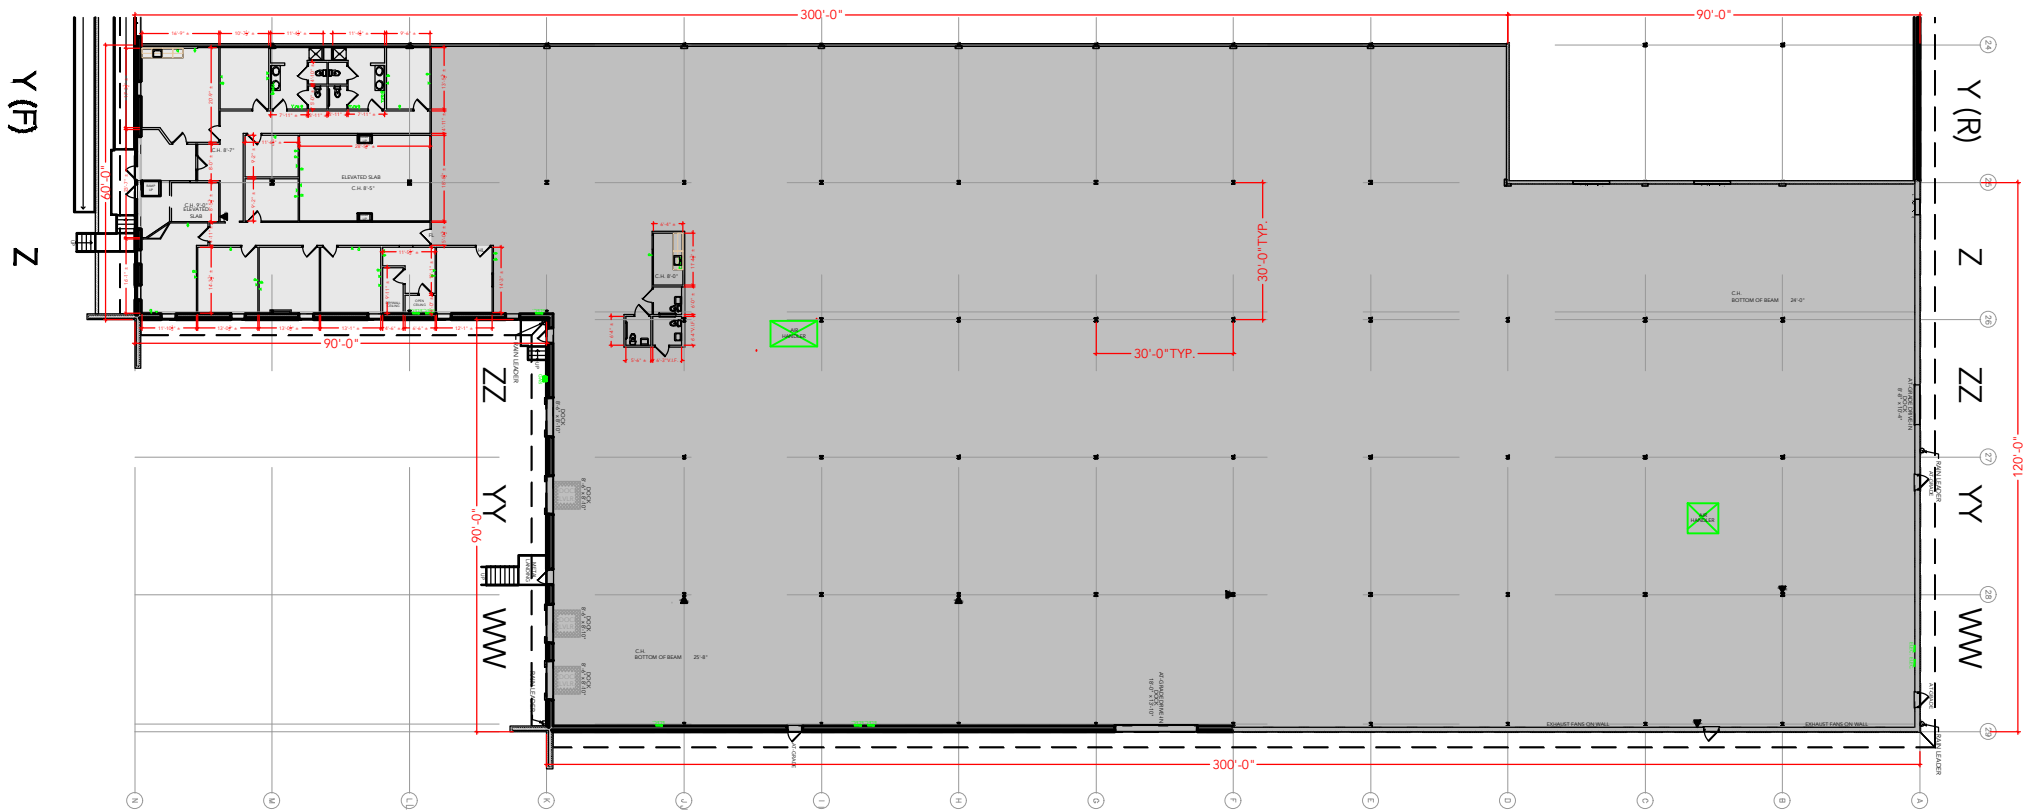

Floor Plan