

TOTAL SF AVAILABLE -9,220 RSF

OFFICE - 2,773 RSF


WAREHOUSE - 6,447 RSF

* INCLUDES % OF METER ROOM

[Click to access CADD file](#)



Key Plan

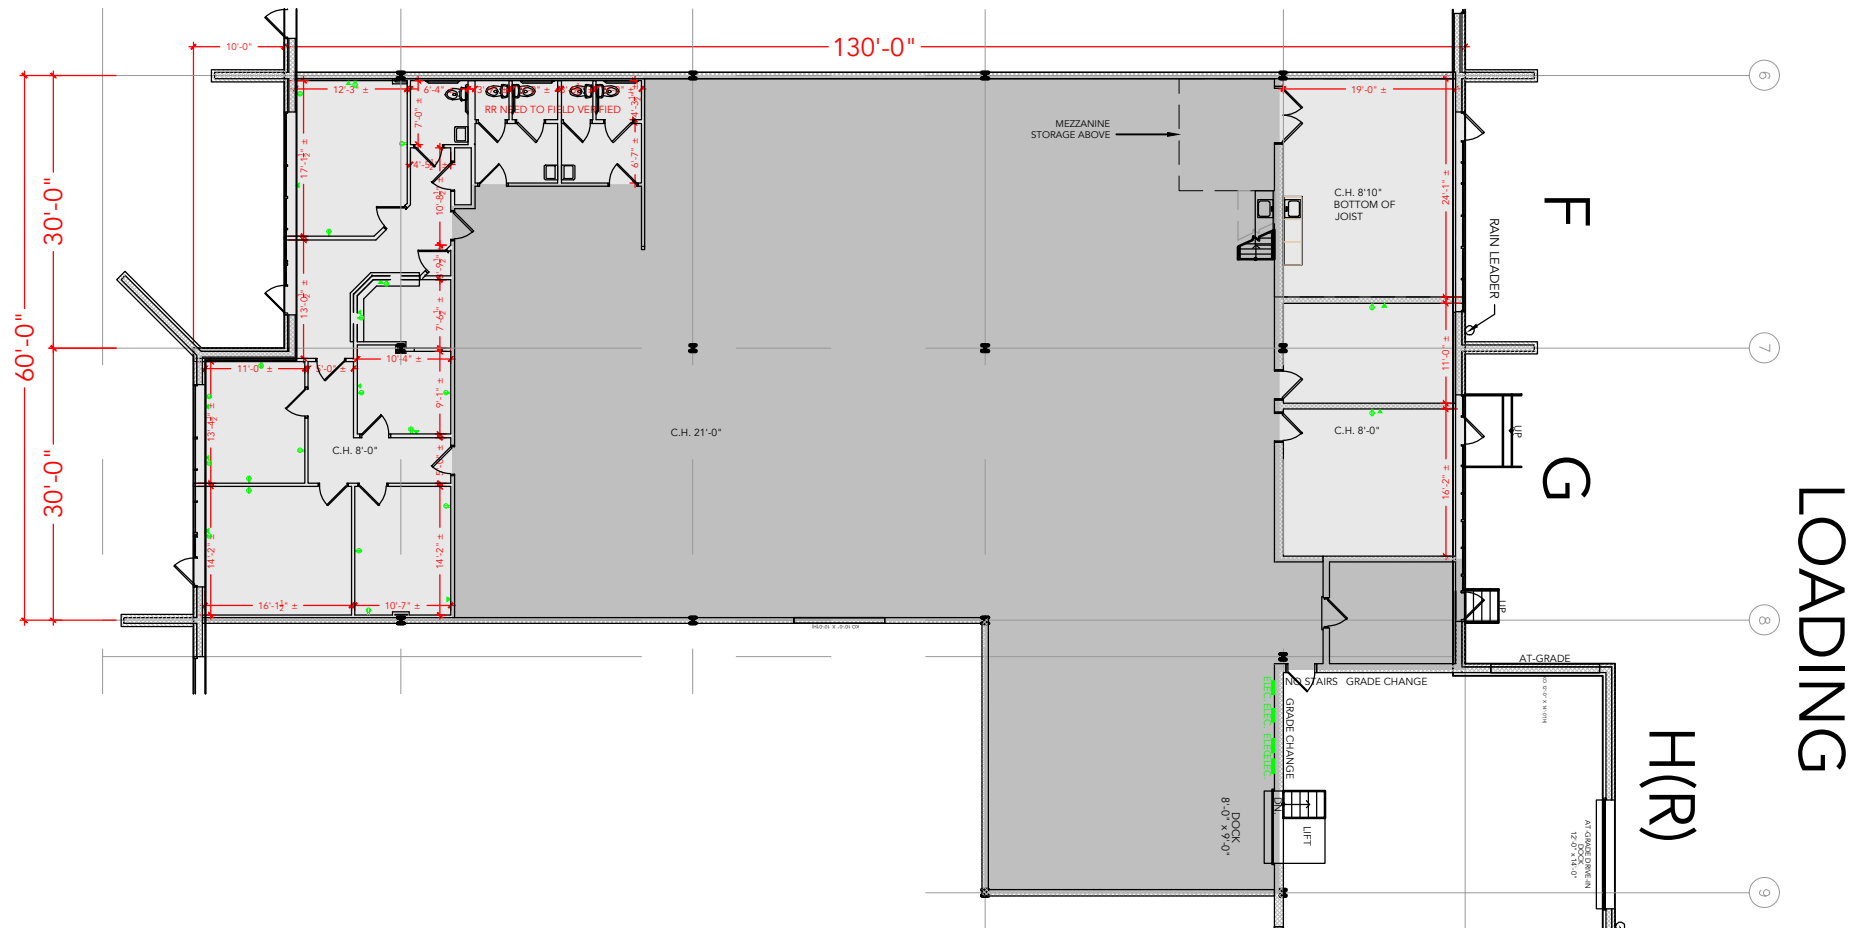

Floor Plan