


TOTAL SF AVAILABLE -7,832 RSF

OFFICE - 903 RSF


WAREHOUSE - 6,930 RSF

* INCLUDES % OF METER ROOM

[Click to access CADD file](#)

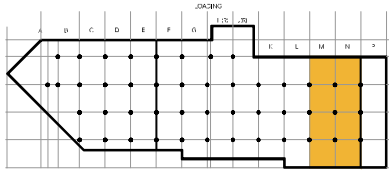

Key Plan

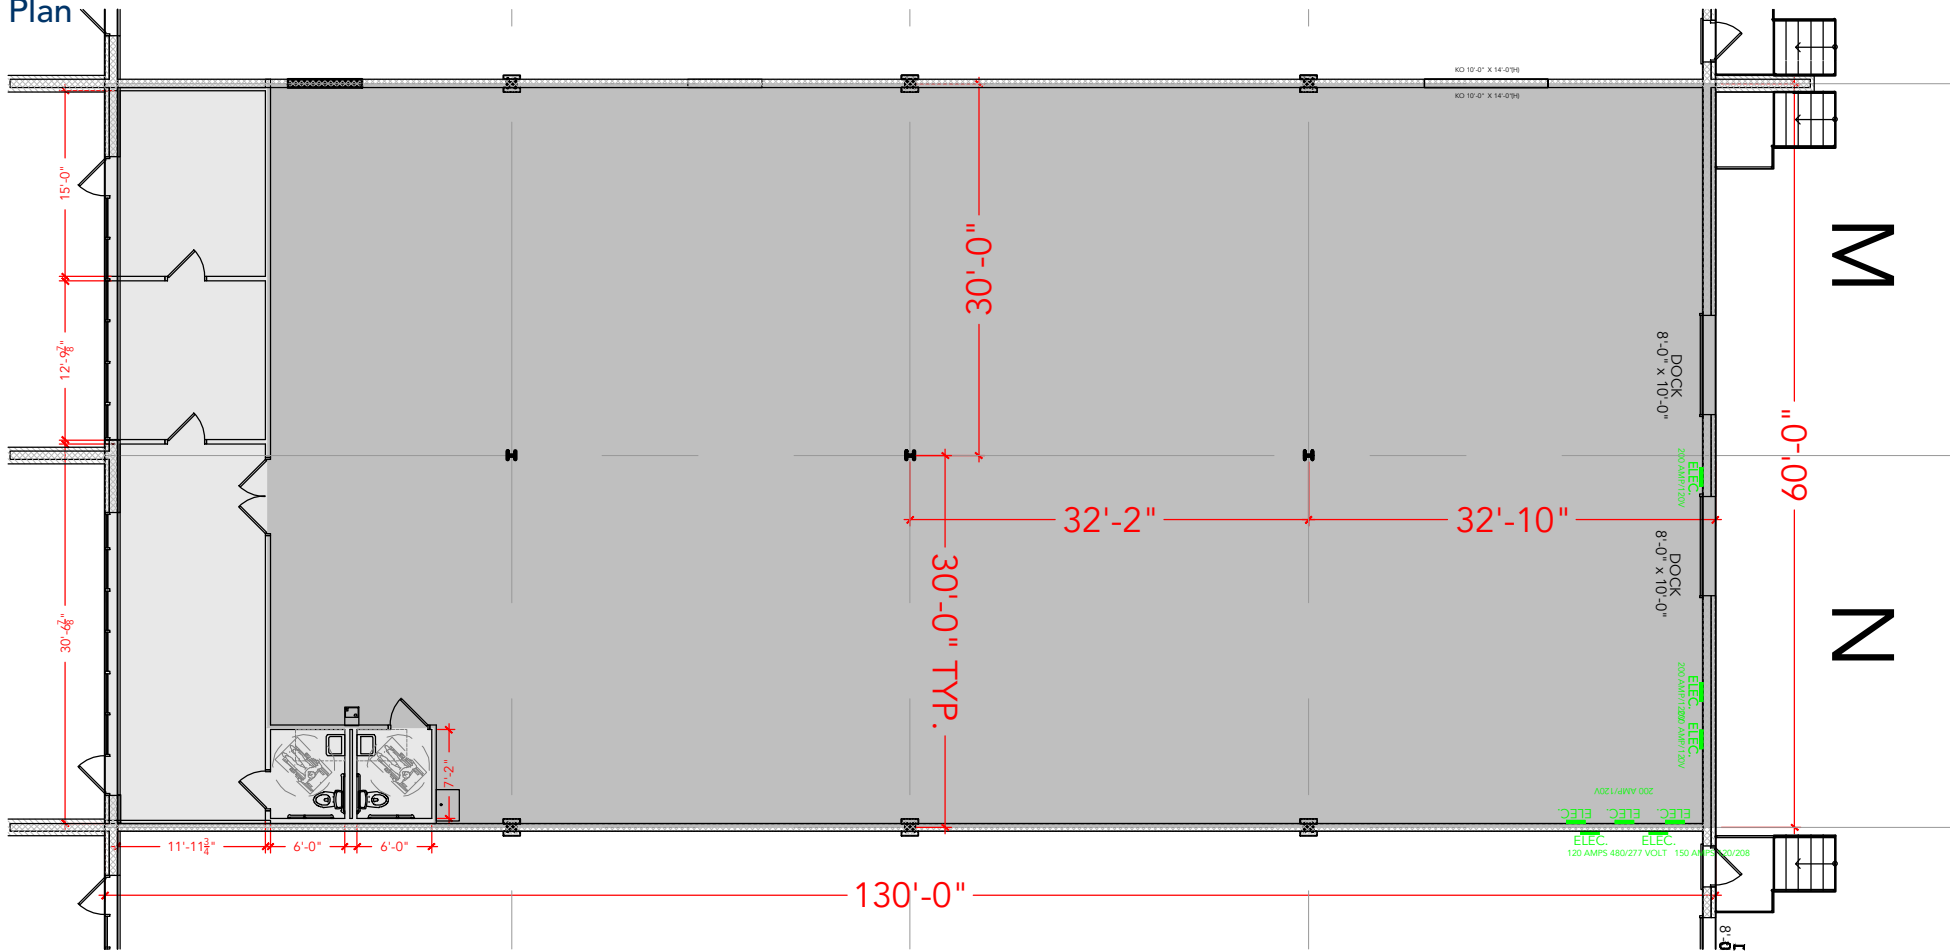

Floor Plan