

TOTAL SF AVAILABLE -7,834 RSF

OFFICE - 333 RSF


WAREHOUSE - 7,501 RSF

* INCLUDES % OF METER ROOM

[Click to access CADD file](#)



Key Plan

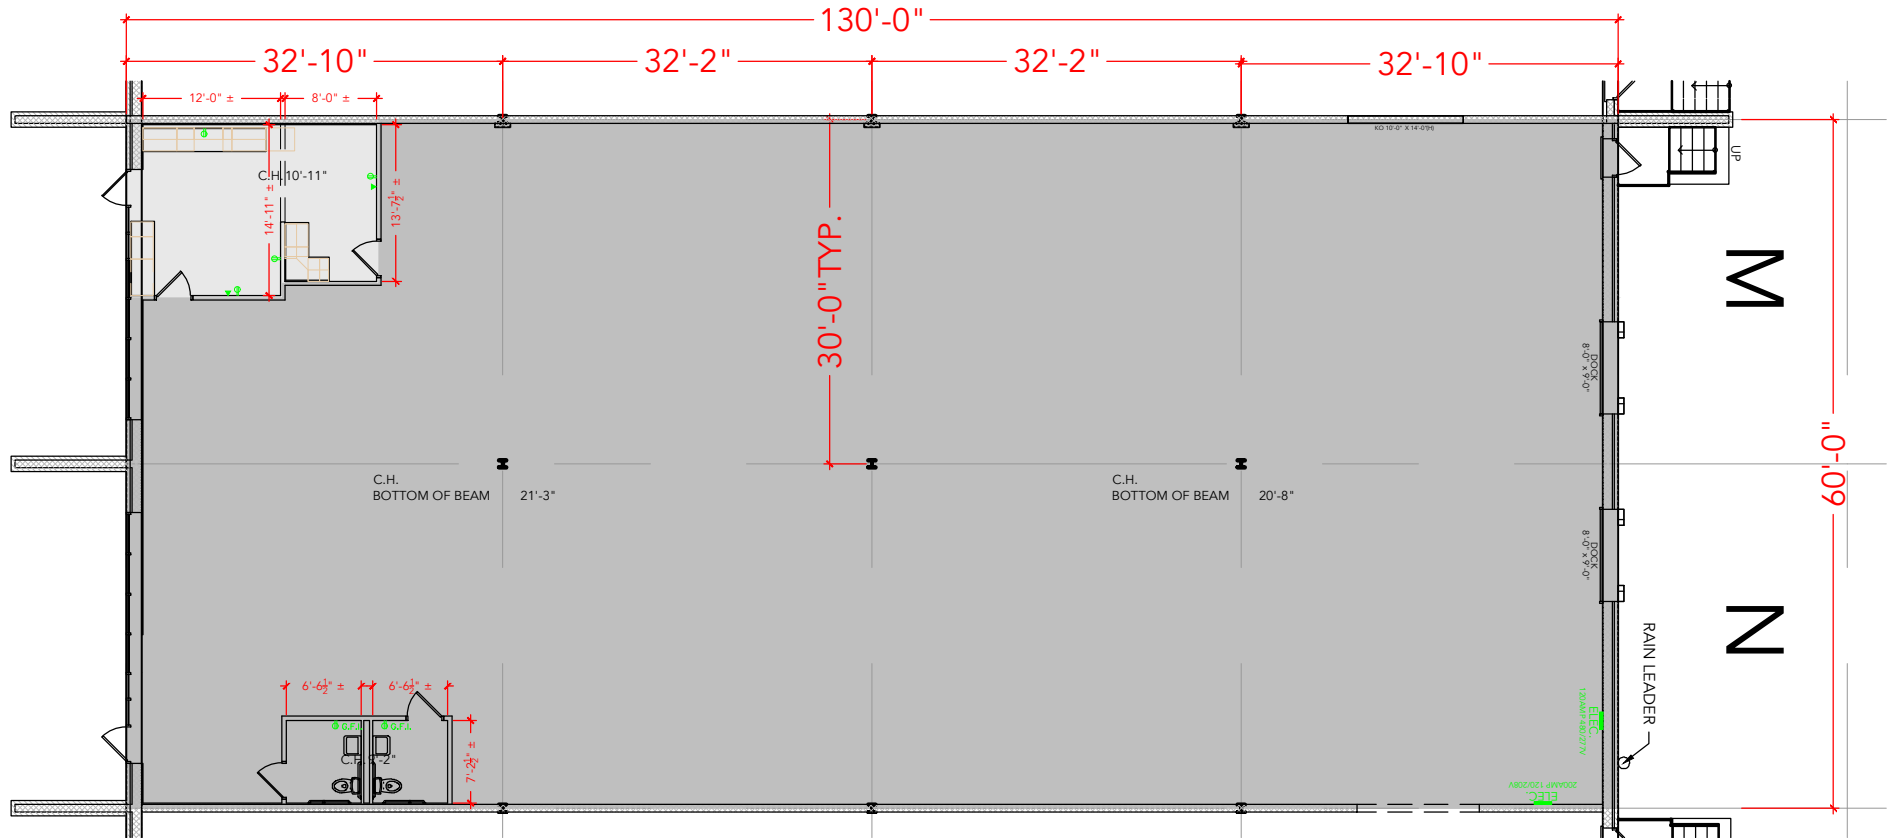

Floor Plan