


TOTAL SF AVAILABLE - 3,900 SF


OFFICE - 2,193 SF

WAREHOUSE - 1,707 SF

[Click to access 3D model](#)

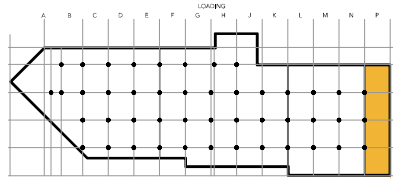

Key Plan

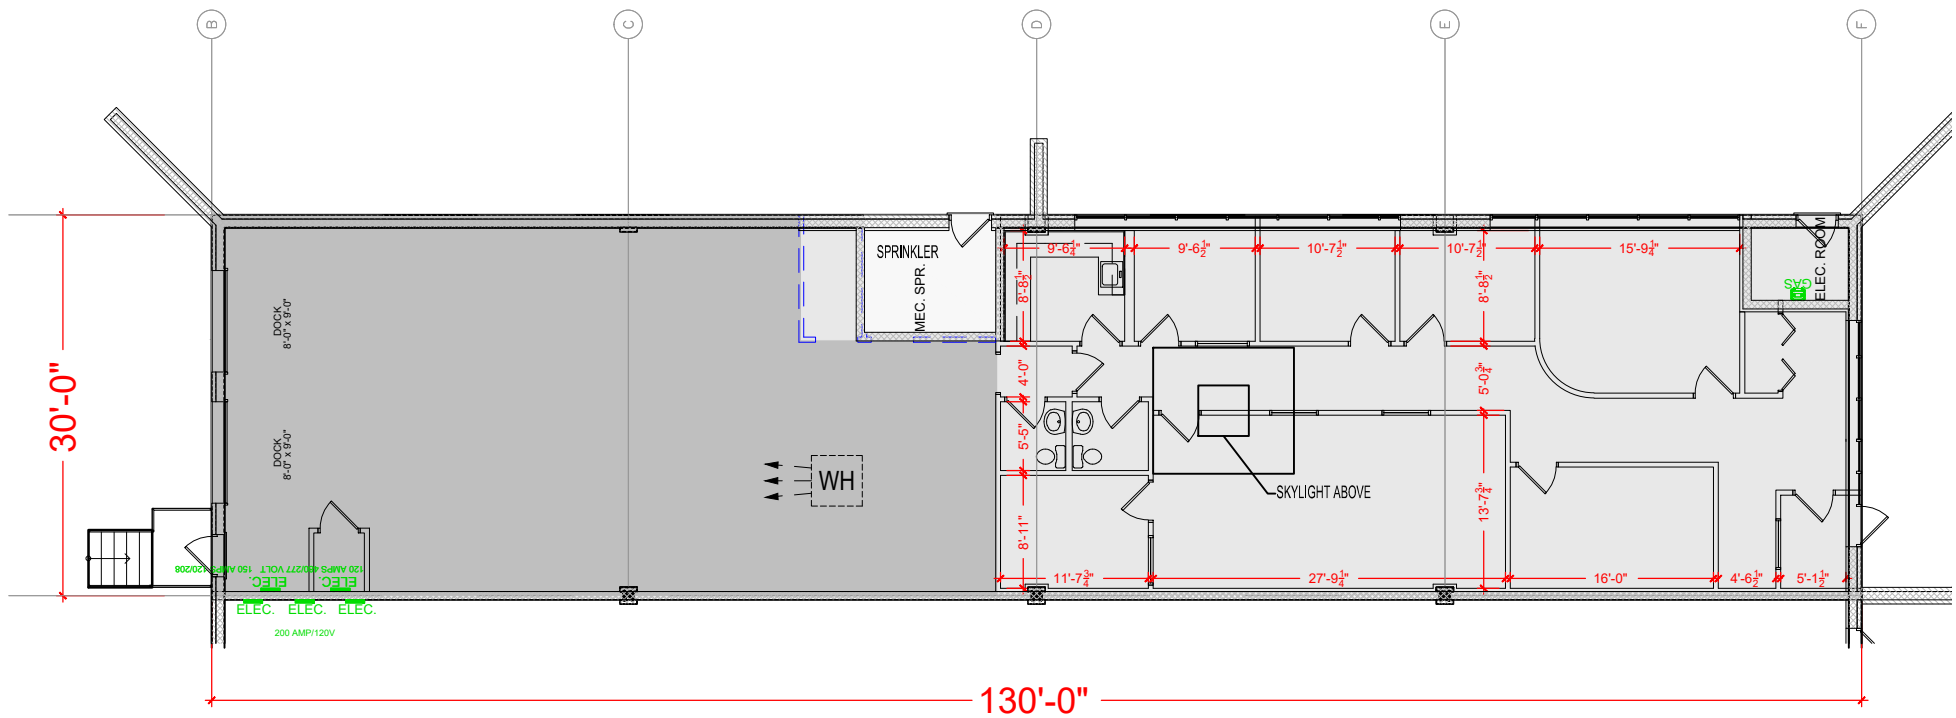

Floor Plan