


**TOTAL SF AVAILABLE - 9,000 SF**


OFFICE - 3,353 SF

WAREHOUSE SF - 6,547 SF

[Click to access 3D model](#)

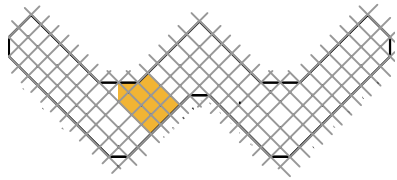

Key Plan

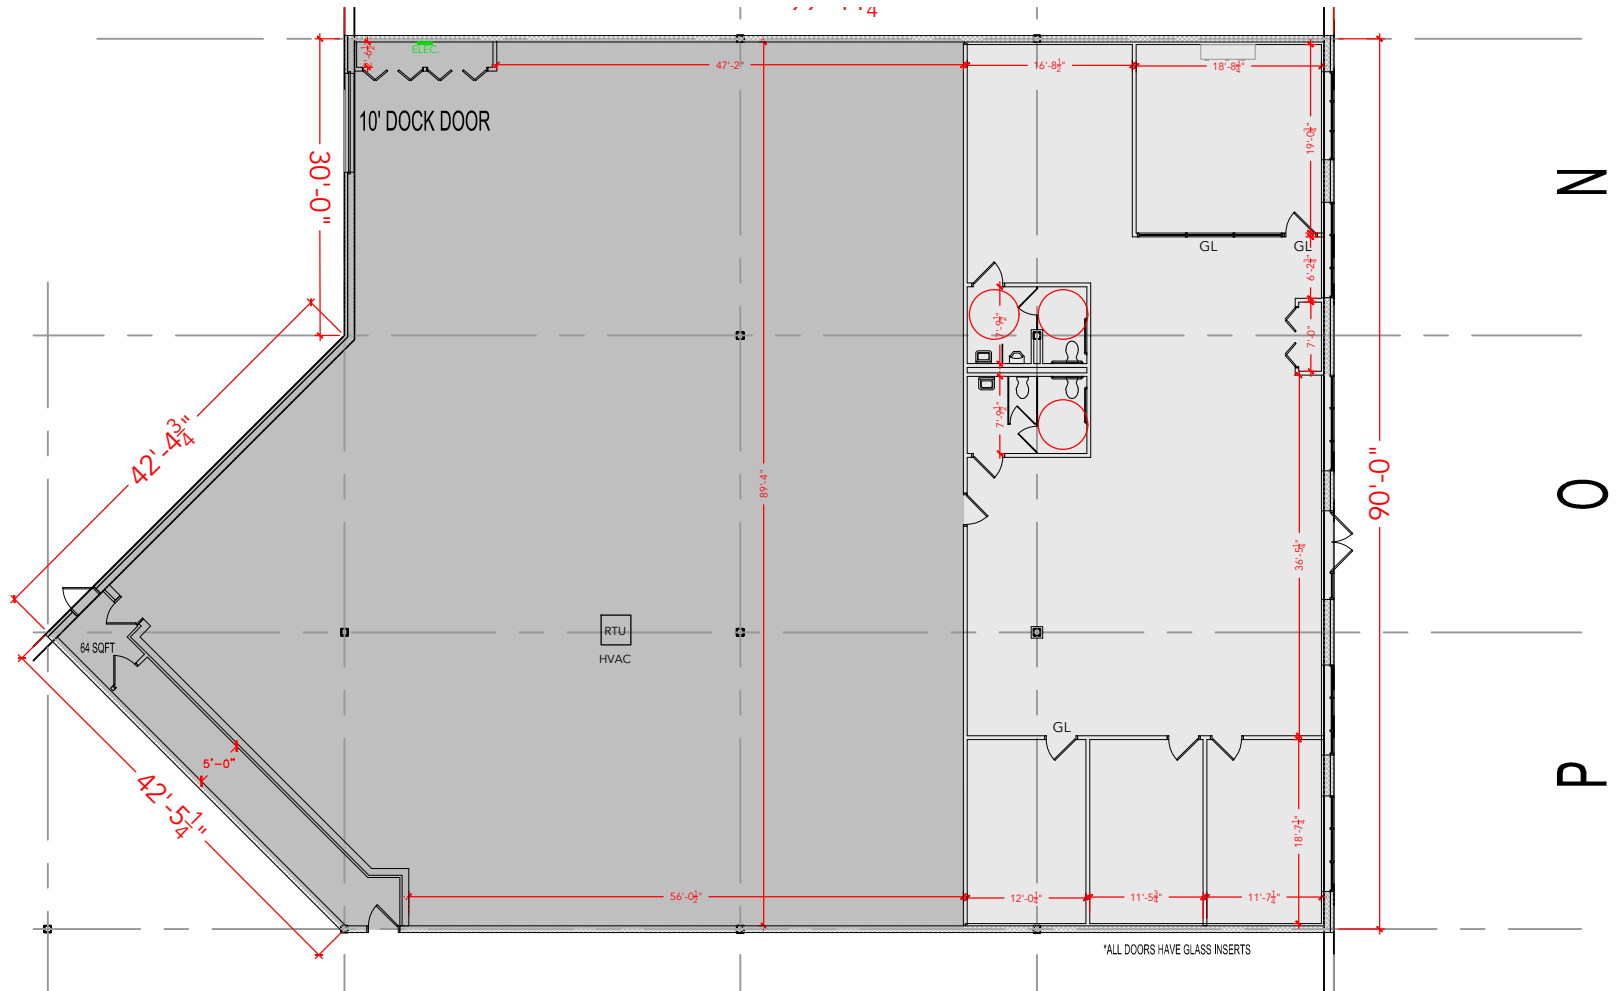

Floor Plan