


TOTAL SF AVAILABLE - 9,642 SF


OFFICE - 3,353 SF

WAREHOUSE SF - 6,299 SF

[Click to access 3D model](#)

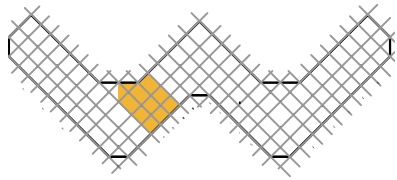

Key Plan

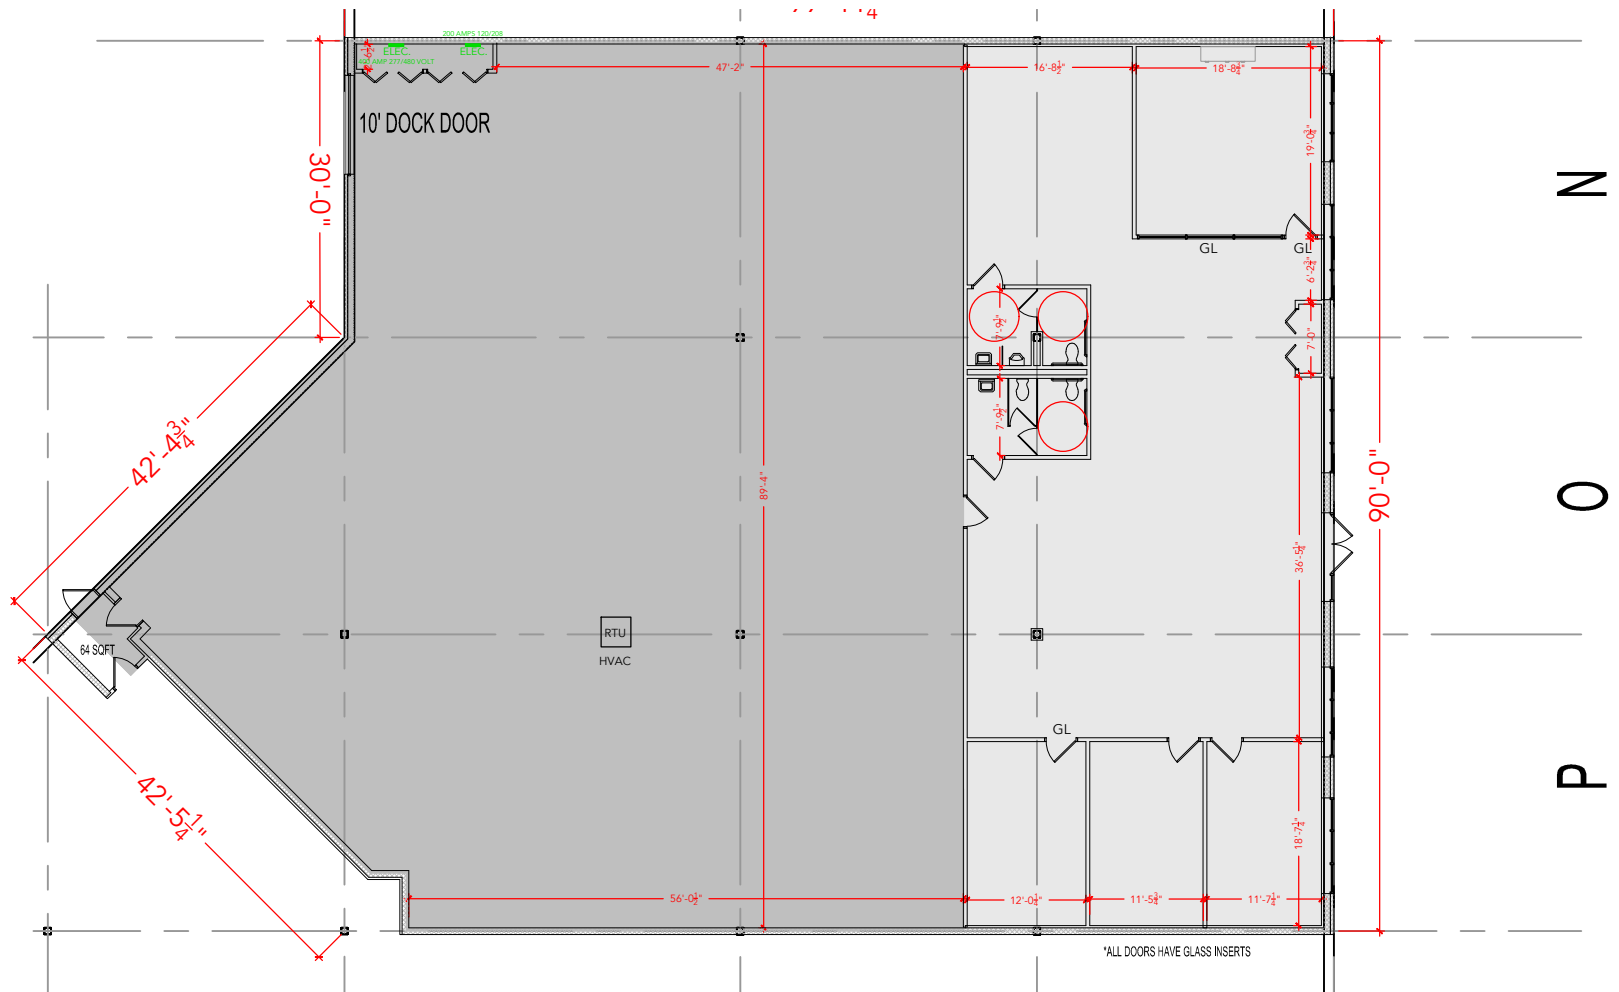

Floor Plan