


TOTAL SF AVAILABLE - 9,808 SF


OFFICE - 9,808 SF

WAREHOUSE SF - 0,000 SF

[Click to access 3D model](#)

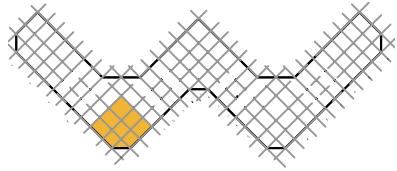

Key Plan

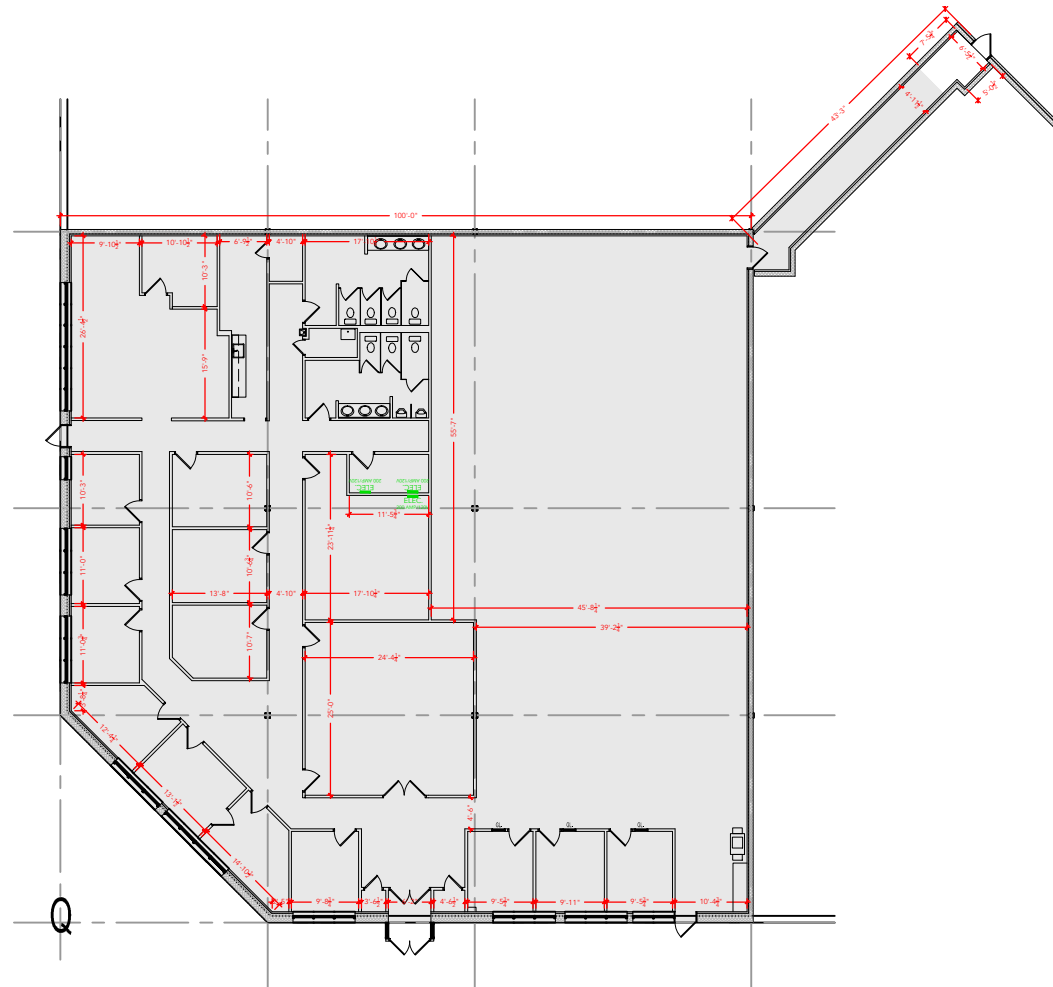

Floor Plan