


## **BALTIMORE COMMONS**

7455 NEW RIDGE RD HANOVER, MD 21076 SUITE Q

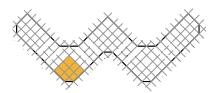


**Key Plan** 

## TOTAL SF AVAILABLE -9,832 SF

OFFICE - 9,832 SF WAREHOUSE SF - 0,000 SF

Click to access3D model

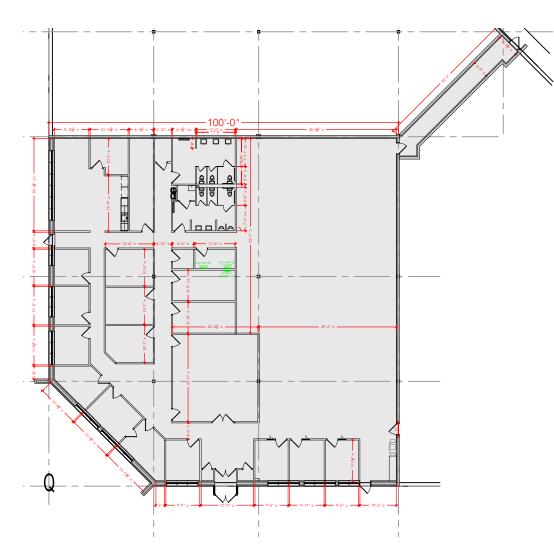

## Floor Plan