


TOTAL SF AVAILABLE - 8,197 SF


OFFICE - 2,066 SF

WAREHOUSE SF - 6,131 SF

[Click to access3D model](#)

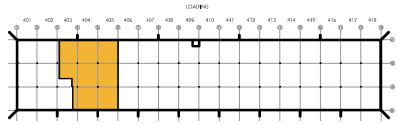

Key Plan

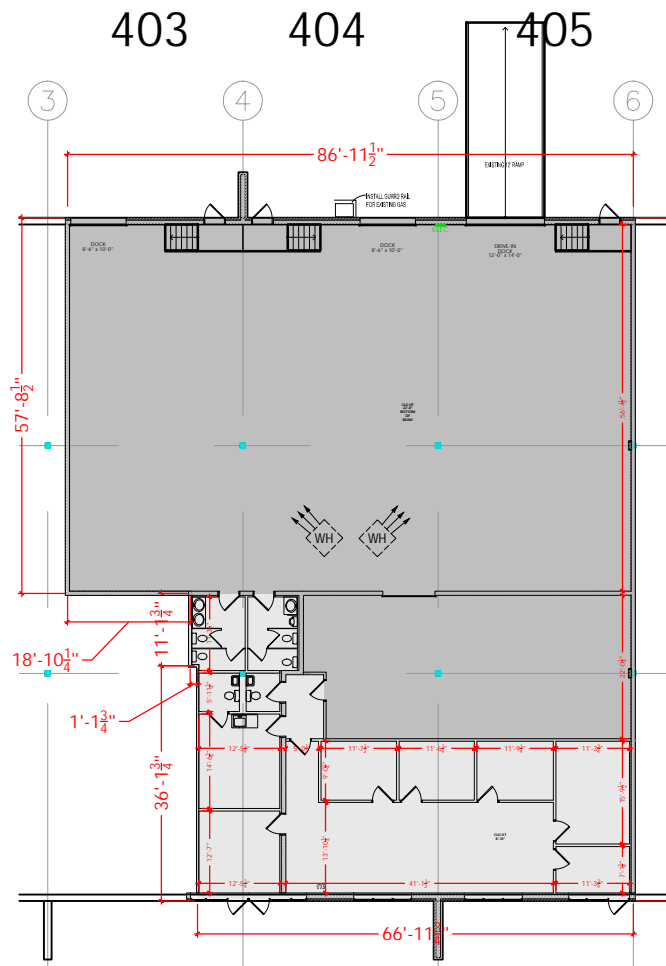

Floor Plan