


TOTAL SF AVAILABLE -6,000 SF


OFFICE - 2,416 SF

WAREHOUSE - 3,584 SF

[Click to access CADD file](#)

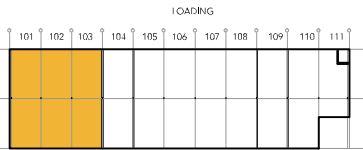

Key Plan

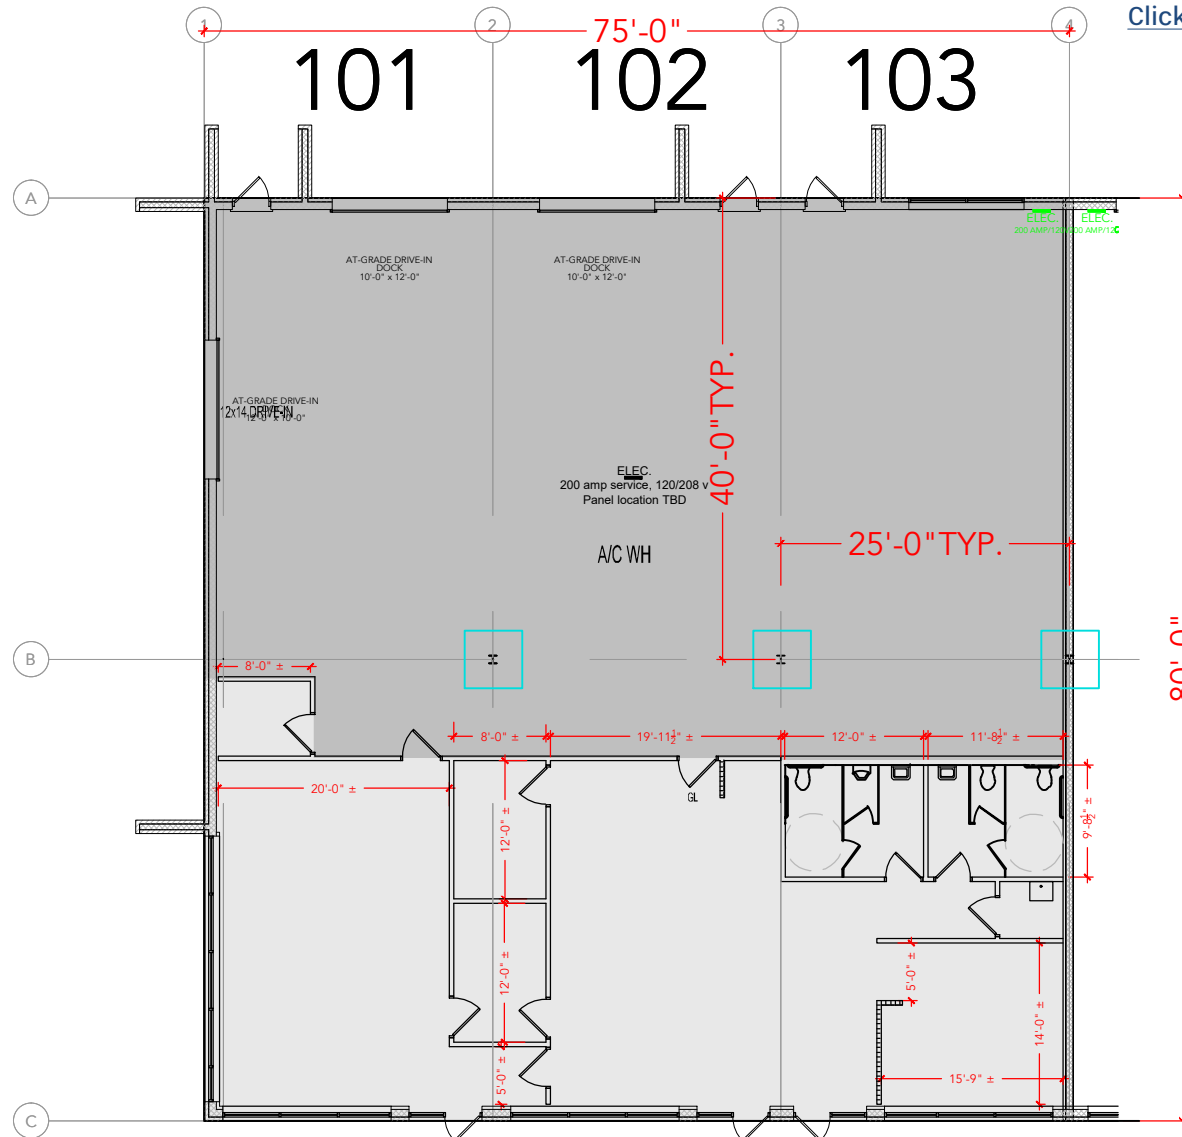

Floor Plan