


TOTAL SF AVAILABLE - 2,000 SF

OFFICE SF - 1,178 SF

WAREHOUSE SF - 822 SF

[Click to access CADD file](#)

Key Plan

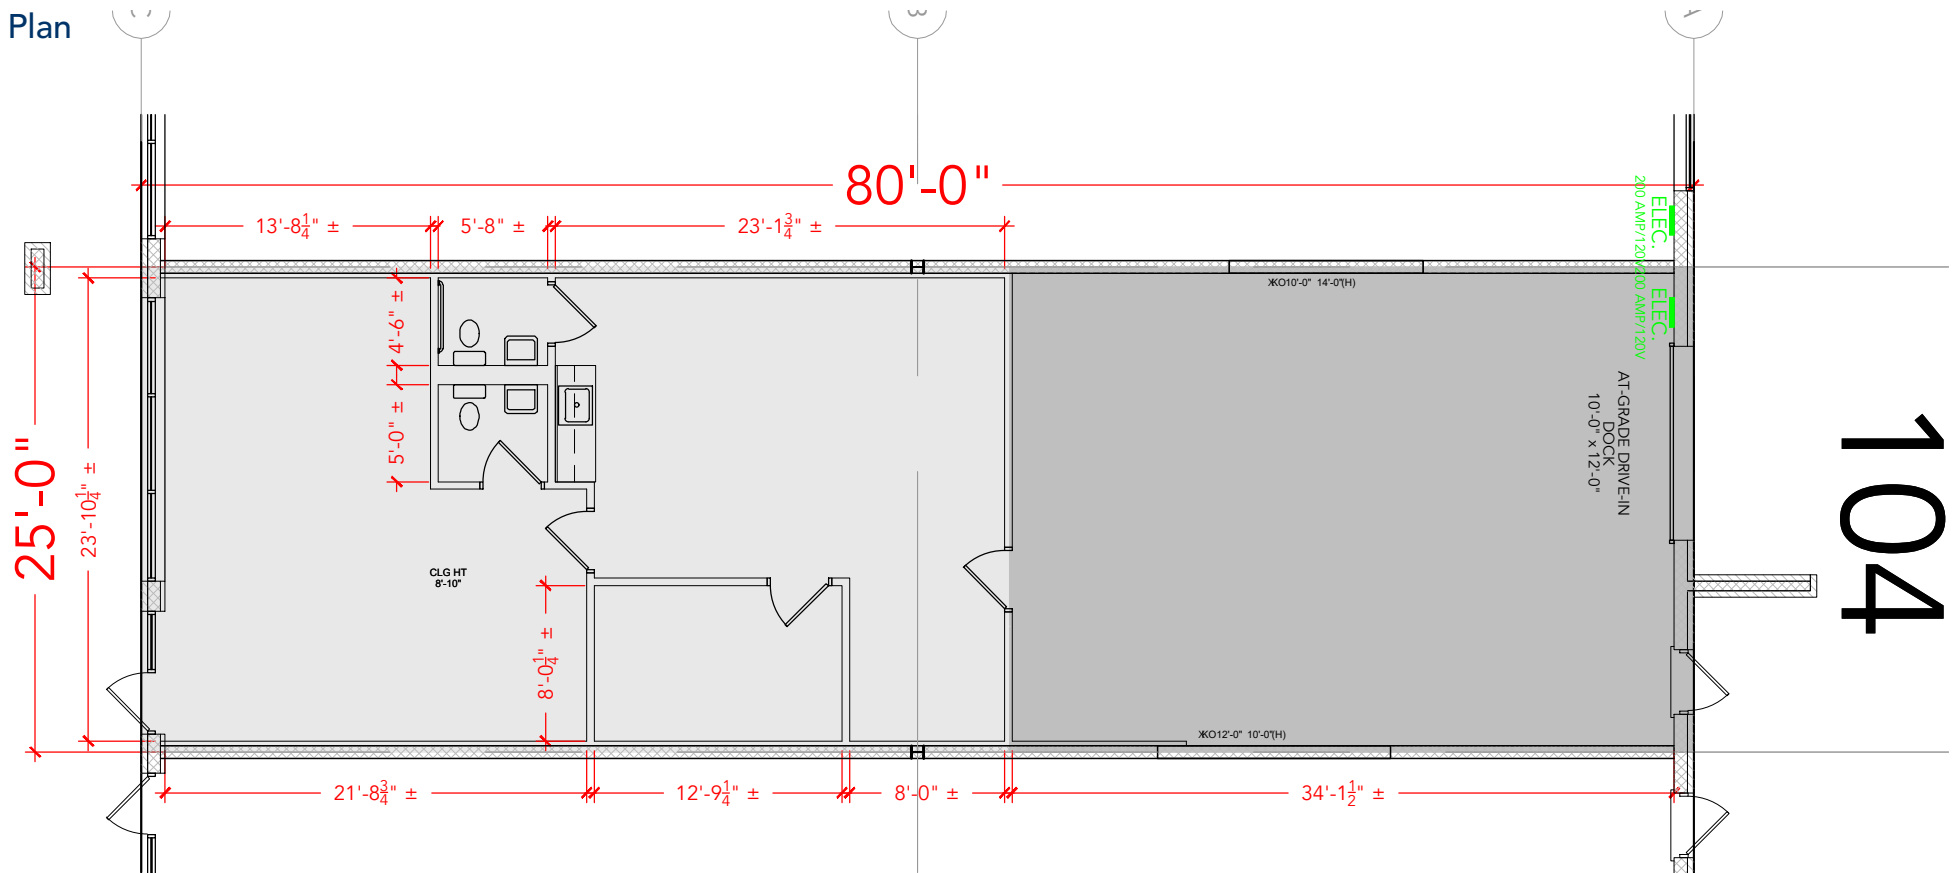

Floor Plan